


SKETCH/AREA TABLE ADDENDUM

SUBJECT INFO

File No.: 321076 Parcel No.: 071W01D 01802
 Property Address: 4111 Amber Ct
 City: Silverton County: State: OR ZipCode: 97381
 Owner:
 Client: Client Address:
 Appraiser Name: Inspection Date:

SKETCH

321076
071W01D 01802

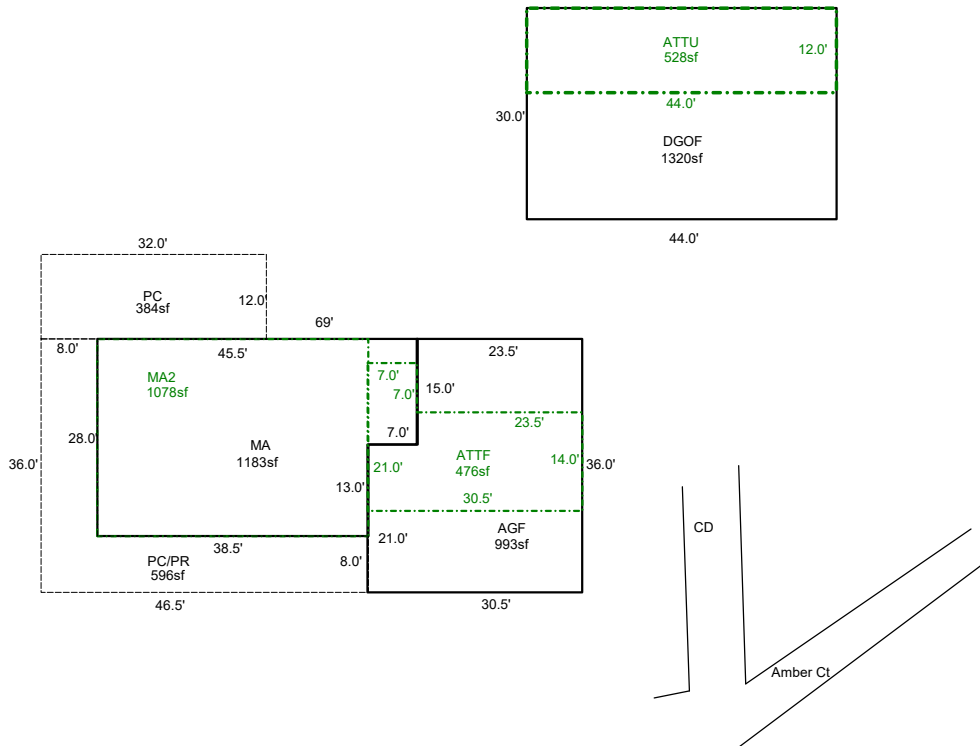

Sketch by ApexSketch

AREA CALCULATIONS SUMMARY

Code	Description	Factor	Net Size	Perimeter	Net Totals
GBA2	ATTU	1.0	528.0	112.0	528.0
GLA1	MA	1.0	1183.0	147.0	1183.0
GLA2	MA2	1.0	1078.0	133.0	1078.0
GAR	AGF	1.0	993.0	133.0	
	ATTU	1.0	476.0	103.0	
	DGO	1.0	1320.0	148.0	2789.0
P/P	PC	1.0	384.0	88.0	
	PC/PR	1.0	596.0	165.0	980.0
	Net LIVABLE	cnt	0 (rounded)		2,261
	Net BUILDING	cnt	1 (rounded)		528

COMMENT TABLE 1

Apex 8/23/12 Jane
 UPDATED BY CLOBERG 04/08/25

COMMENT TABLE 2

MLH 04/04/25

COMMENT TABLE 3

SV L4

SKETCH/AREA TABLE ADDENDUM

Parcel No 071W01D 01802

File No R321076

Property Address 4111 Amber Ct

City Silverton

State OR




Zip 97381

Owner

Client

Appraiser Name

R321076
071W01D 01802

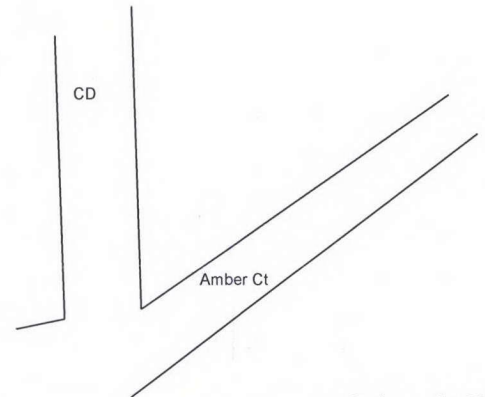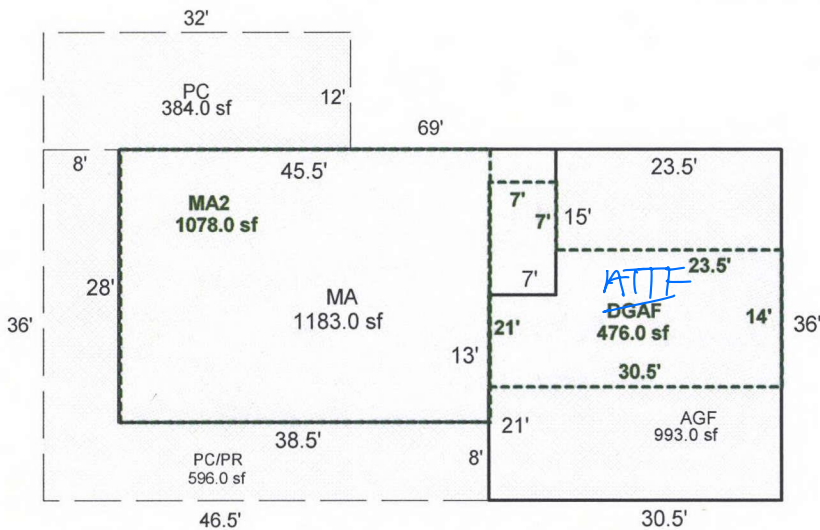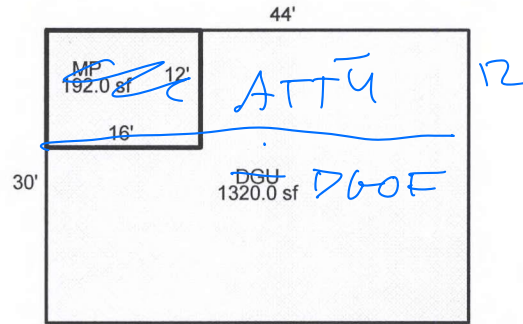

Scale: 1 = 20

AREA CALCULATIONS SUMMARY

Code	Description	Factor	Net Size	Perimeter	Net Totals
GLA1	MA	1.00	1183.0	147.0	1183.0
GLA2	MA2	1.00	1078.0	133.0	1078.0
GBA1	MP	1.00	192.0	56.0	192.0
GAR	AGF	1.00	993.0	133.0	
	DGAF	1.00	476.0	103.0	
	DGU	1.00	1320.0	148.0	2789.0
P/P	PC	1.00	384.0	88.0	
	PC/PR	1.00	596.0	165.0	980.0
Net LIVABLE Area (rounded w/ factors)					2261
Net BUILDING Area (rounded w/ factors)					192

Comment Table 1

Apex 8/23/12 Jane

Comment Table 2

1/4/25 MCH SU LY

Comment Table 3









11:10:00