


SKETCH/AREA TABLE ADDENDUM

SUBJECT INFO				
File No.: 102049		Parcel No.: 061W35CA09800		
Property Address: 515 S 3RD ST				
City: SILVERTON		County: Marion	State: OR	ZipCode: 97381
Owner:				
Client:		Client Address:		
Appraiser Name:		Inspection Date:		

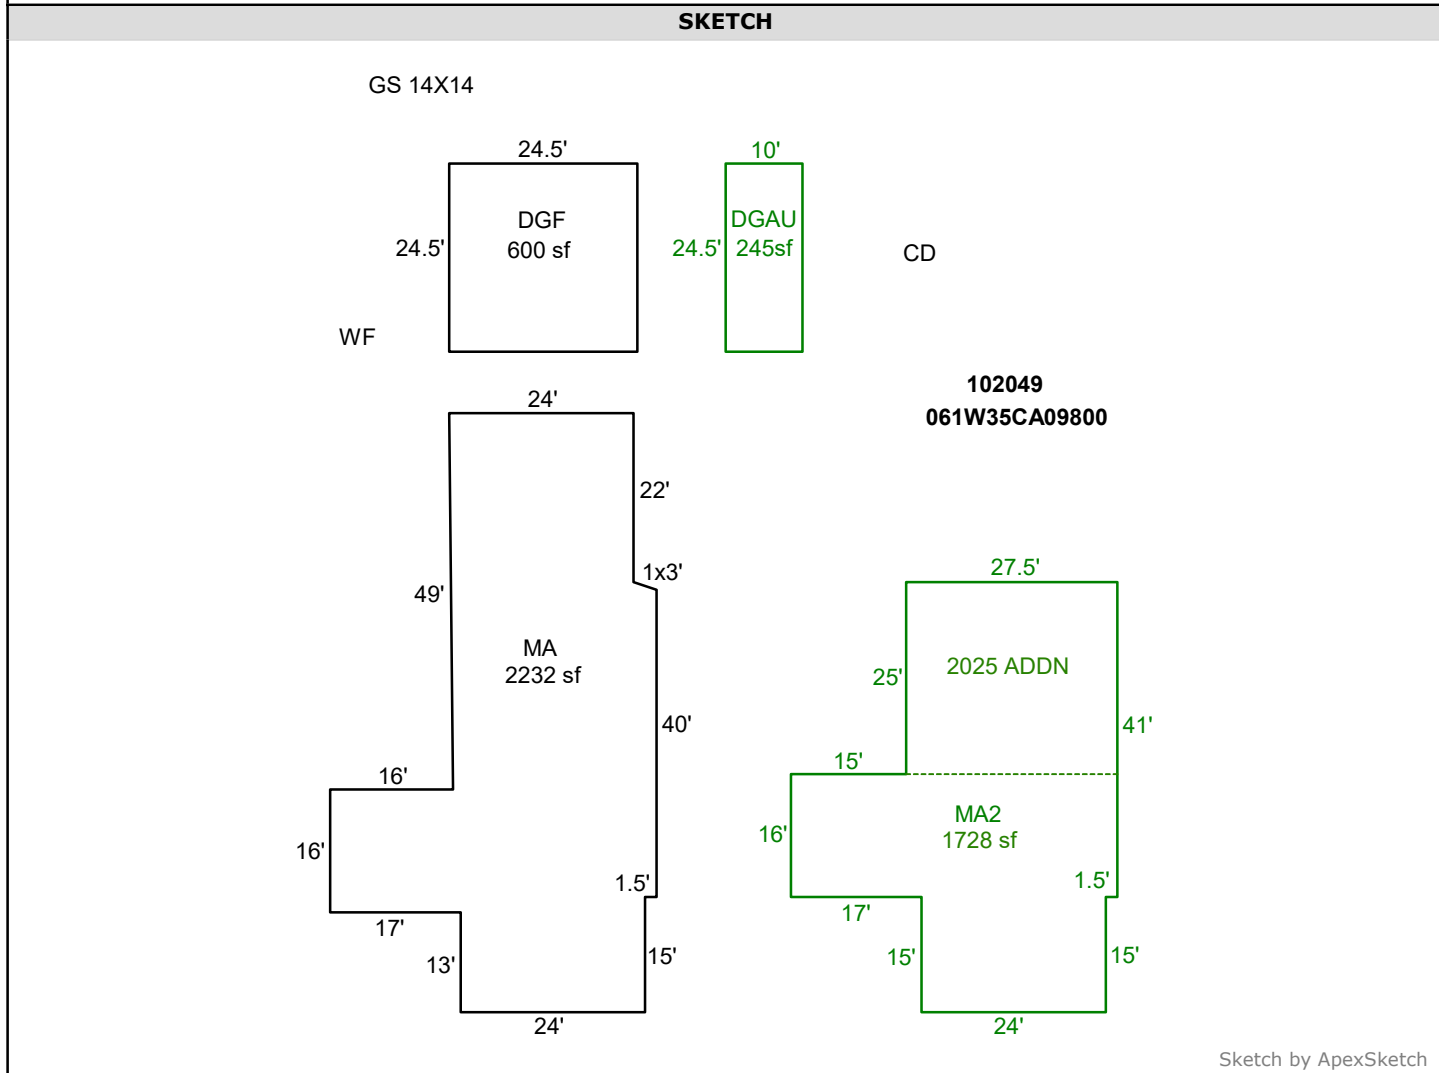

AREA CALCULATIONS SUMMARY						COMMENT TABLE 1	
Code	Description	Factor	Net Size	Perimeter	Net Totals	Drawn by Pat Long 04/24/2009 UPDATED 12/16/13 BY TINA Updated by AE 5.22.25	
GLA	MA	1.0	2232.3	240.7	2232.3		
GLA2	MA2	1.0	1727.5	197.0	1727.5		
GAR	DGF	1.0	600.3	98.0			
	DGAU	1.0	245.0	69.0	845.3		
Net LIVABLE						COMMENT TABLE 2	COMMENT TABLE 3
Net LIVABLE							
		cnt	2	(rounded)	3,960		