


SKETCH/AREA TABLE ADDENDUM

SUBJECT INFO			
File No.: 610040		Parcel No.: 052W13DB11300	
Property Address: 2488 Sawtelle Dr			
City: Woodburn	County: Marion	State: OR	ZipCode: 97071
Owner:			
Client:	Client Address:		
Appraiser Name:		Inspection Date:	

SKETCH

610040
052W13DB11300

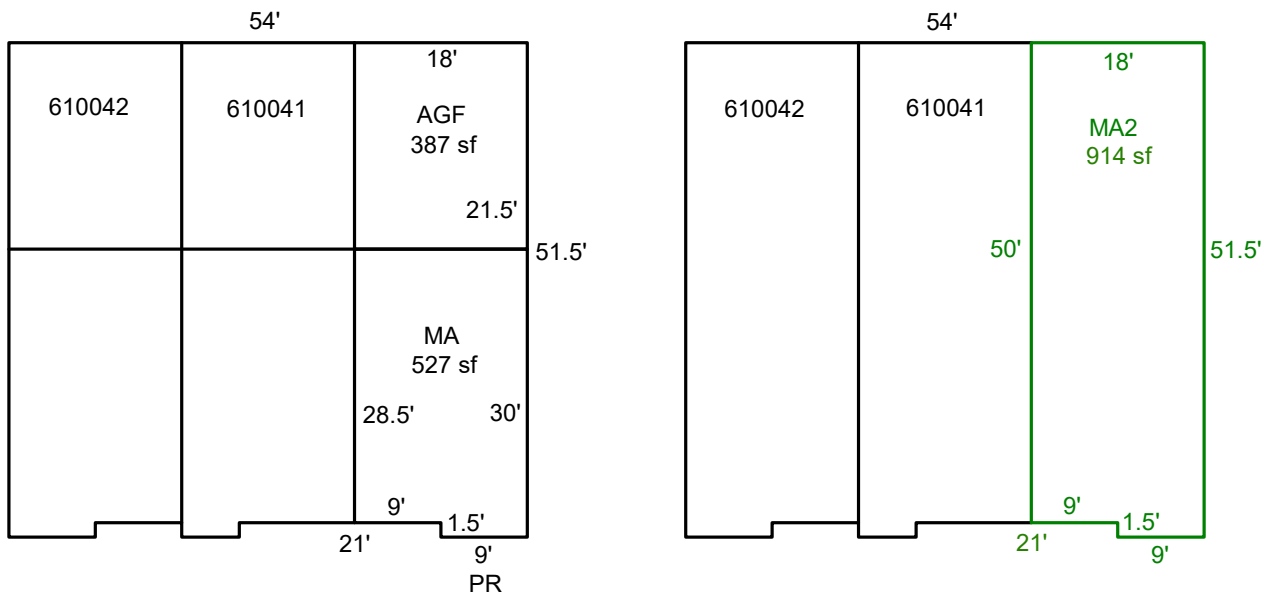

Sketch by ApexSketch

[illegible]