


SKETCH/AREA TABLE ADDENDUM




SUBJECT INFO

File No.: 596489 Parcel No.: 073W26AB09000
 Property Address: 425 17TH ST NE
 City: SALEM County: Marion State: OR ZipCode: 97301
 Owner:
 Client: Client Address:
 Appraiser Name: Inspection Date:

SKETCH

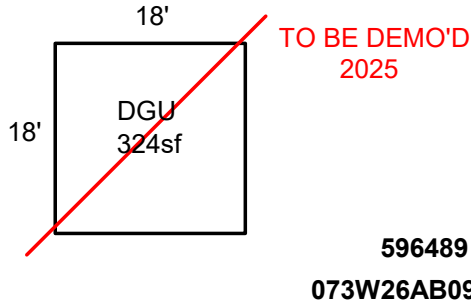

596489
073W26AB09000

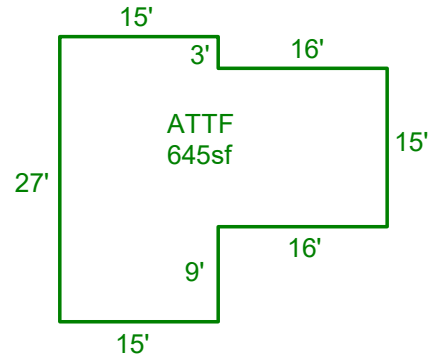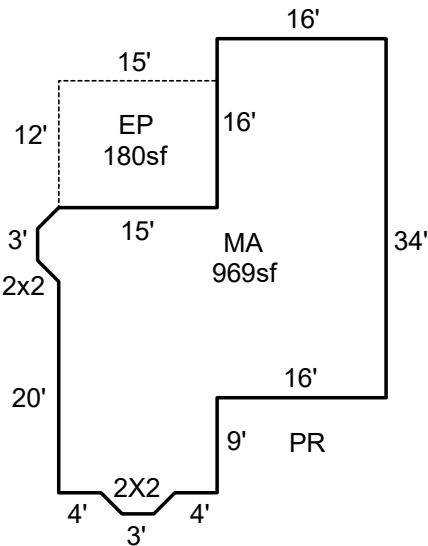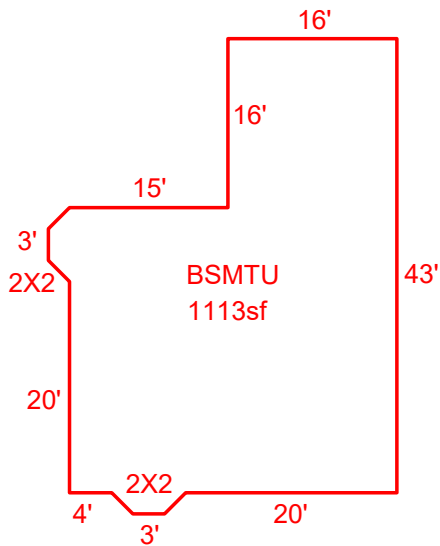

Sketch by ApexSketch

AREA CALCULATIONS SUMMARY

Code	Description	Factor	Net Size	Perimeter	Net Totals
GLA	MA	1.0	969.0	151.3	969.0
GLA2	ATTF	1.0	645.0	116.0	645.0
BSMT	BSMTU	1.0	1113.0	151.3	1113.0
GAR	DGU	1.0	324.0	72.0	324.0
P/P	EP	1.0	180.0	54.0	180.0

COMMENT TABLE 1

DRAWN BY PST 11/13/08
Updated by AE 7.14.25

COMMENT TABLE 2

10/30/08 54

COMMENT TABLE 3

Net LIVABLE cnt 2 (rounded) 1,614