


SKETCH/AREA TABLE ADDENDUM

SUBJECT INFO

File No.: 328444 Parcel No.: 084W24B001101
 Property Address: 6314 JACINDA LN S
 City: SALEM County: Marion State: OR ZipCode:
 Owner:
 Client: Client Address:
 Appraiser Name: Inspection Date:

SKETCH

328444
084W24B001101
SCALE 1:30

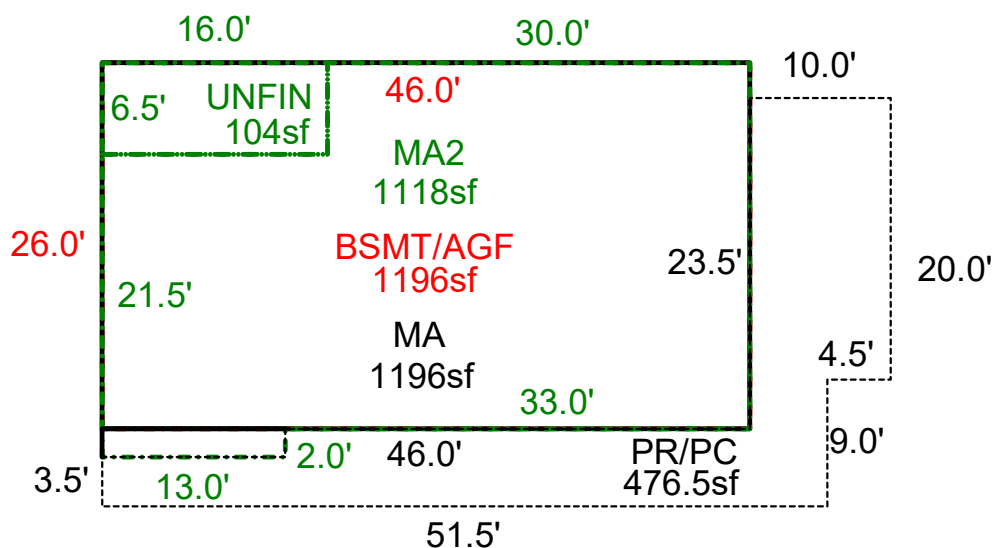

Sketch by ApexSketch

AREA CALCULATIONS SUMMARY						COMMENT TABLE 1	
Code	Description	Factor	Net Size	Perimeter	Net Totals		
MA2	MA2	1.0	1118.0	148.0		APEX BY CLOBERG 07/07/25 24-005351 MA UPDATED BY CLOBERG 07/17/25 24-005351 REV-01	
	UNFIN	1.0	104.0	45.0	1222.0		
BSMTF	BSMT/AGF	1.0	1196.0	144.0	1196.0		
MA	MA	1.0	1196.0	144.0	1196.0		
P/P	PR/PC	1.0	476.5	170.0	476.5		
<p style="text-align: center;">Net LIVABLE cnt 3 (rounded) 2,418</p>						COMMENT TABLE 2	COMMENT TABLE 3