

Acct ID: 536921 MTL: 102W090000100 Date: 5/15/25 Appr: MDL Prop Class: 551 RMV Prop Class: 501
 Situs: 16014 PLETZER RD SE TURNER OR 97392 MaSaNh: 07 06 000 Unit: 148053 Year: 2024
 Last Date Appraised: 04/10/2017 Appraiser: MATT LORD Retag: Y (N) Tag info: 7/8/25
 Owner: WEYERHAEUSER NR COMPANY Roll Type: R
 Cycle Tag Sales Verification Other: _____ Inspection level: 1 2 (3) 4 LCB TTO INSP AV: 1455013
 RMV Land: 417820 RMV Imp: 1367080 RMV Total: 1784900 MAV: 1273970 MSAV: 181273 SAV: 510022
 Comment:

Notations 25-26 cycle

RP/MS	Code	Description
RP	ZONED	FARM EFU ZONED

OSDs

Count	Code	Description	RMV	Code Area	Exception
1	SAA	SA OSD - AVERAGE	45000	05535	0

Land

Site: 2	Code Area: 05535	Size: 1.00 Acres	Use Code: 005	Zone: REST	SAV Use: 011	Exception: 0
Class: 2BDS	Value Source: Farm Homesite	Description: TWO BENCH DRY SOUTH SPECIAL	RMV: 3030	Exception: Y	N	
Adjustment(s): GSOIL, WASTE, IRR			Fire Patrol:	Description:		
Comments: Liability year - 2009 / 00550130						
Site: 3	Code Area: 05535	Size: 100.25 Acres	Use Code: 005	Zone: REST	SAV Use: 011	Exception: 0
Class: 2BISS	Value Source: Farm Use - EFU	Description: TWO BENCH IRR SOUTH SPECIAL	RMV: 317040	Exception: Y	N	
Adjustment(s): GSOIL, WASTE, IRR			Fire Patrol:	Description:		
Comments: Liability year - 1980 / 00550130						
Site: 4	Code Area: 05535	Size: 17.10 Acres	Use Code: 005	Zone: REST	SAV Use: 011	Exception: 0
Class: 4BISS	Value Source: Farm Use - EFU	Description: FOUR BENCH IRR SPECIAL SOUTH	RMV: 49380	Exception: Y	N	
Adjustment(s): GSOIL, WASTE, IRR			Fire Patrol:	Description:		
Comments: Liability year - 1985 / 00550130						
Site: 5	Code Area: 05535	Size: 40.80 Acres	Use Code: 005	Zone: REST	SAV Use: 011	Exception: 0
Class: WST	Value Source: WASTE RURAL	Description: Rural WASTELAND	RMV: 3370	Exception: Y	N	
Adjustment(s): GSOIL, WASTE, IRR			Fire Patrol:	Description:		
Comments: Liability year - 1980 / 00550130 UNDERLYING SOILS 2BD, 4BD, AND 8 NORTH SANTIAM RIVER, SLOUGH, WET						

Improvements - Residence / Manufactured Structures

Bldg: 1	Code Area: 05535	Stat Class: 141	Year Blt: 1972	Eff Year Blt: 1972	Sq.Ft: 1709	% Complete: 100
Desc: One Story Only			Dimensions:	RMV: 242140		
Func Obsc: 100	Econ %: 100	Other %: 100	Exception: 0	Adjust:	Adjust RMV: 0	

Floors

Type	Class	Display Group	Floor Size	Beds	Baths	Yr Blt	Eff Yr Blt	Inventory	Exception:
First Floor	4	Finished	1709	3	FB-2	1972	1972	BATH - 2, KIT, HVAC, FP - 1, ROOF	Y N
Garage Attached	4	Finished	624	0	0	1972	1972	ROOF	Y N

Accessories

Description	Class	Size SqFt	Eff Yr Blt	RMV	Quantity	Exception:
YARD IMPROVEMENTS AVERAGE	4	1	1972	20925	1	Y N

Bldg: 14	Code Area: 05535	Stat Class: 108	Year Blt: 1985	Eff Year Blt: 1985	Sq.Ft: 0	% Complete: 100
Desc: Residential Other Improvements			Dimensions:	RMV: 143650		
Func Obsc: 80	Econ %: 100	Other %: 100	Exception: 0	Adjust:	Adjust RMV: 0	

Floors

Type	Class	Display Group	Floor Size	Beds	Baths	Yr Blt	Eff Yr Blt	Inventory
No floor data available								

Accessories

Description	Class	Size SqFt	Eff Yr Blt	RMV	Quantity	Exception:
ASPHALT DRIVEWAY	1	110500	1985	143650	1	Y N

Bldg: 23	Code Area: 05535	Stat Class: 108	Year Blt: 1985	Eff Year Blt: 1985	Sq.Ft: 0	% Complete: 100
Desc: Residential Other Improvements			Dimensions:	RMV: 70720		
Func Obsc: 100	Econ %: 100	Other %: 100	Exception: 0	Adjust:	Adjust RMV: 0	

Floors

Type	Class	Display Group	Floor Size	Beds	Baths	Yr Blt	Eff Yr Blt	Inventory
No floor data available								

Part of VI

Accessories

Description	Class	Size SqFt	Eff Yr Blt	RMV	Quantity
PATIO	1	15875	1985	70723	1

Exception: Y N

Improvements - Accessory Buildings

Bldg: 2	Code Area: 05535	Stat Class: 351	Year Blt: 2000	Eff Year Blt: 2000	Sq.Ft: 1768	% Complete: 100
Desc: General Purpose Building (GB)					Dimensions: 34x26	RMV: 22170
Func Obsc: 100	Econ %: 100	Other %: 100	Exception: 0	Adjust:	Adjust RMV: 0	

Floors

Type	Class	Display Group	Floor Size	Beds	Baths	Yr Blt	Eff Yr Blt	Inventory
General Purpose Bldg	6	Finished	884	0	FB-2	2000	2000	BATH - 2
Finished Office	6	Finished	884	0	0	1985	1985	FAIR

Exception: Y N

Exception: Y N

Accessories

Description	Class	Size SqFt	Eff Yr Blt	RMV	Quantity
No accessory data available					

Bldg: 3	Code Area: 05535	Stat Class: 351	Year Blt: 1985	Eff Year Blt: 1985	Sq.Ft: 3680	% Complete: 100
Desc: General Purpose Building (GB)					Dimensions: 92x40	RMV: 20470
Func Obsc: 100	Econ %: 100	Other %: 100	Exception: 0	Adjust:	Adjust RMV: 0	

Floors

Type	Class	Display Group	Floor Size	Beds	Baths	Yr Blt	Eff Yr Blt	Inventory
General Purpose Bldg	6	Finished	3680	0	0	1985	1985	FAIR

Exception: Y N

Accessories

Description	Class	Size SqFt	Eff Yr Blt	RMV	Quantity
No accessory data available					

Bldg: 4	Code Area: 05535	Stat Class: 351	Year Blt: 1985	Eff Year Blt: 1985	Sq.Ft: 3240	% Complete: 100
Desc: General Purpose Building (GB)					Dimensions: 54x30	RMV: 23900
Func Obsc: 100	Econ %: 100	Other %: 100	Exception: 0	Adjust:	Adjust RMV: 0	

Floors

Type	Class	Display Group	Floor Size	Beds	Baths	Yr Blt	Eff Yr Blt	Inventory
General Purpose Bldg	6	Finished	1620	0	FB-2	1985	1985	BATH - 2
Finished Office	6	Finished	1620	0	0	1985	1985	FAIR

Exception: Y N

Exception: Y N

Accessories

Description	Class	Size SqFt	Eff Yr Blt	RMV	Quantity
No accessory data available					

Bldg: 5	Code Area: 05535	Stat Class: 351	Year Blt: 1985	Eff Year Blt: 1985	Sq.Ft: 2976	% Complete: 100
Desc: General Purpose Building (GB)					Dimensions: 62x48	RMV: 16190
Func Obsc: 100	Econ %: 100	Other %: 100	Exception: 0	Adjust:	Adjust RMV: 0	

Floors

Type	Class	Display Group	Floor Size	Beds	Baths	Yr Blt	Eff Yr Blt	Inventory
General Purpose Bldg	5	Finished	2976	0	0	1985	1985	AVG Fair

Exception: Y N

Accessories

Description	Class	Size SqFt	Eff Yr Blt	RMV	Quantity
No accessory data available					

Bldg: 6	Code Area: 05535	Stat Class: 355	Year Blt: 1985	Eff Year Blt: 1985	Sq.Ft: 1000	% Complete: 100
Desc: Lean-to Heavy (LTH)					Dimensions: 50x20	RMV: 1940
Func Obsc: 100	Econ %: 100	Other %: 100	Exception: 0	Adjust:	Adjust RMV: 0	

Floors

Type	Class	Display Group	Floor Size	Beds	Baths	Yr Blt	Eff Yr Blt	Inventory
Lean-to Heavy Duty	4	Finished	1000	0	0	1985	1985	FAIR

Exception: Y N

Remove

Accessories

Description	Class	Size SqFt	Eff Yr Blt	RMV	Quantity
No accessory data available					

Bldg: 7	Code Area: 05535	Stat Class: 353	Year Blt: 1985	Eff Year Blt: 1985	Sq.Ft: 2550	% Complete: 100
---------	------------------	-----------------	----------------	--------------------	-------------	-----------------

Desc: Machine Shed (MS)				Dimensions: 85x30		RMV: 8590		
Func Obsc: 100	Econ %: 100	Other %: 100	Exception: 0		Adjust: <u>110,000</u>	Adjust RMV: 0		
Floors								
Type	Class	Display Group	Floor Size	Beds	Baths	Yr Blt	Eff Yr Blt	Inventory
Machine Shed	5	Finished	2550 <u>3300</u>	0	0	1985	1985	FAIR
Exception: Y N								

Accessories							
Description	Class	Size SqFt	Eff Yr Blt	RMV	Quantity		
No accessory data available							

Bldg: 8	Code Area: 05535	Stat Class: 351	Year Blt: 1985	Eff Year Blt: 1985	Sq.Ft: 3350	% Complete: 100	
Desc: General Purpose Building (GB)				Dimensions: 110x25		RMV: 20710	
Func Obsc: 100	Econ %: 100	Other %: 100	Exception: 0		Adjust:	Adjust RMV: 0	

Floors								
Type	Class	Display Group	Floor Size	Beds	Baths	Yr Blt	Eff Yr Blt	Inventory
General Purpose Bldg	6	Finished	2750	0	0	1985	1985	FAIR
Exception: Y N								
Finished Office	6	Finished	600	0	0	1985	1985	FAIR
Exception: Y N								

Accessories							
Description	Class	Size SqFt	Eff Yr Blt	RMV	Quantity		
No accessory data available							

Bldg: 9	Code Area: 05535	Stat Class: 341	Year Blt: 1985	Eff Year Blt: 1985	Sq.Ft: 121	% Complete: 100	
Desc: Multi Purpose Shed (MP)				Dimensions: 11x11		RMV: 840	
Func Obsc: 100	Econ %: 100	Other %: 100	Exception: 0		Adjust:	Adjust RMV: 0	

Floors								
Type	Class	Display Group	Floor Size	Beds	Baths	Yr Blt	Eff Yr Blt	Inventory
Multi-Purpose Bldg	5	Finished	121	0	0	1985	1985	FAIR
Exception: Y N								

Accessories							
Description	Class	Size SqFt	Eff Yr Blt	RMV	Quantity		
No accessory data available							

Bldg: 10	Code Area: 05535	Stat Class: 341	Year Blt:	Eff Year Blt:	Sq.Ft: 64	% Complete: 100	
Desc: Multi Purpose Shed (MP)				Dimensions: 8x8		RMV: 260	
Func Obsc: 100	Econ %: 100	Other %: 100	Exception: 0		Adjust:	Adjust RMV: 0	

Floors								
Type	Class	Display Group	Floor Size	Beds	Baths	Yr Blt	Eff Yr Blt	Inventory
Multi-Purpose Bldg	6	Finished	64	0	0	0	0	FAIR
Exception: Y N								

Accessories							
Description	Class	Size SqFt	Eff Yr Blt	RMV	Quantity		
No accessory data available							

Bldg: 11	Code Area: 05535	Stat Class: 341	Year Blt:	Eff Year Blt:	Sq.Ft: 96	% Complete: 100	
Desc: Multi Purpose Shed (MP)				Dimensions: 12x8		RMV: 390	
Func Obsc: 100	Econ %: 100	Other %: 100	Exception: 0		Adjust:	Adjust RMV: 0	

Floors								
Type	Class	Display Group	Floor Size	Beds	Baths	Yr Blt	Eff Yr Blt	Inventory
Multi-Purpose Bldg	6	Finished	96	0	0	0	0	FAIR
Exception: Y N								

Accessories							
Description	Class	Size SqFt	Eff Yr Blt	RMV	Quantity		
No accessory data available							

Bldg: 12	Code Area: 05535	Stat Class: 341	Year Blt: 1985	Eff Year Blt: 1985	Sq.Ft: 312	% Complete: 100	
Desc: Multi Purpose Shed (MP)				Dimensions: 26x12		RMV: 2990	
Func Obsc: 100	Econ %: 100	Other %: 100	Exception: 0		Adjust:	Adjust RMV: 0	

Floors								
Type	Class	Display Group	Floor Size	Beds	Baths	Yr Blt	Eff Yr Blt	Inventory
Multi-Purpose Bldg	6	Finished	312	0	0	1985	1985	FAIR
Exception: Y N								

Accessories							
Description	Class	Size SqFt	Eff Yr Blt	RMV	Quantity		
No accessory data available							

Bldg: 13	Code Area: 05535	Stat Class: 351	Year Blt: 1985	Eff Year Blt: 1985	Sq.Ft: 1584	% Complete: 100	
Desc: General Purpose Building (GB)				Dimensions: 44x36		RMV: 9900	

Func Obsc: 100	Econ %: 100	Other %: 100	Exception: 0	Adjust:	Adjust RMV: 0				
Floors									
Type	Class	Display Group	Floor Size	Beds	Baths	Yr Blt	Eff Yr Blt	Inventory	
General Purpose Bldg	6	Finished	1584	0	FB-1/ HB-1	1985	1985	FAIR, BTH - 1	Exception: Y N
Accessories									
Description	Class	Size SqFt	Eff Yr Blt	RMV	Quantity				
No accessory data available									
Bldg: 15 ✓	Code Area: 05535	Stat Class: 351	Year Blt: 1985	Eff Year Blt: 1985	Sq.Ft: 6125 ⁴²⁰⁰			% Complete: 100	
Desc: General Purpose Building (GB)					Dimensions: 35x120			RMV: 38670	
Func Obsc: 100	Econ %: 100	Other %: 100	Exception: 0	Adjust:	Adjust RMV: 0				
Floors									
Type	Class	Display Group	Floor Size	Beds	Baths	Yr Blt	Eff Yr Blt	Inventory	
General Purpose Bldg	6	Finished	4200	0	0	1985	1985	FAIR	Exception: Y N
Finished Office	6	Finished	1925	0	0	1985	1985		Exception: Y N
Accessories									
Description	Class	Size SqFt	Eff Yr Blt	RMV	Quantity				
No accessory data available									
Bldg: 16	Code Area: 05535	Stat Class: 301	Year Blt:	Eff Year Blt:	Sq.Ft: 2660			% Complete: 100	
Desc: Accessory Improvements & Misc.					Dimensions: 76x35			RMV: 25000	
Func Obsc: 100	Econ %: 100	Other %: 100	Exception: 0	Adjust:	Adjust RMV: 0				
Floors									
Type	Class	Display Group	Floor Size	Beds	Baths	Yr Blt	Eff Yr Blt	Inventory	
Building Structure	0	Finished	2660	0	0	0	0		Exception: Y N
Accessories									
Description	Class	Size SqFt	Eff Yr Blt	RMV	Quantity				
No accessory data available									
Bldg: 17 ✓	Code Area: 05535	Stat Class: 351	Year Blt: 1985	Eff Year Blt: 1985	Sq.Ft: 14480 ³⁶⁰			% Complete: 100	
Desc: General Purpose Building (GB)					Dimensions: 362x40			RMV: 47200	
Func Obsc: 100	Econ %: 100	Other %: 100	Exception: 0	Adjust:	Adjust RMV: 0				
Floors									
Type	Class	Display Group	Floor Size	Beds	Baths	Yr Blt	Eff Yr Blt	Inventory	
General Purpose Bldg	4	Finished	14480	0	0	1985	1985	FAIR	Exception: Y N
Accessories									
Description	Class	Size SqFt	Eff Yr Blt	RMV	Quantity				
No accessory data available									
Bldg: 18 ✓	Code Area: 05535	Stat Class: 332	Year Blt: 2008	Eff Year Blt: 2008	Sq.Ft: 19800			% Complete: 100	
Desc: Commercial Greenhouse (CG)					Dimensions: 110x180			RMV: 153990	
Func Obsc: 100	Econ %: 100	Other %: 100	Exception: 0	Adjust:	Adjust RMV: 0				
Floors									
Type	Class	Display Group	Floor Size	Beds	Baths	Yr Blt	Eff Yr Blt	Inventory	
Commerical Greenhouse	6	Finished	19800	0	0	2008	2008		Exception: Y N
Accessories									
Description	Class	Size SqFt	Eff Yr Blt	RMV	Quantity				
No accessory data available									
Bldg: 19	Code Area: 05535	Stat Class: 301	Year Blt: 2001	Eff Year Blt: 2001	Sq.Ft: 0			% Complete: 100	
Desc: Accessory Improvements & Misc.					Dimensions:			RMV: 5500	
Func Obsc: 100	Econ %: 100	Other %: 100	Exception: 0	Adjust:	Adjust RMV: 0				
Floors									
Type	Class	Display Group	Floor Size	Beds	Baths	Yr Blt	Eff Yr Blt	Inventory	
Building Structure	0	Finished	0	0	0	2001	2001		Exception: Y N
Accessories									
Description	Class	Size SqFt	Eff Yr Blt	RMV	Quantity				
No accessory data available									
Bldg: 20	Code Area: 05535	Stat Class: 301	Year Blt: 2001	Eff Year Blt: 2001	Sq.Ft: 3200			% Complete: 100	
Desc: Accessory Improvements & Misc.					Dimensions: 40x80			RMV: 25000	

Func Obsc: 100	Econ %: 100	Other %: 100	Exception: 0	Adjust:	Adjust RMV: 0				
Floors									
Type	Class	Display Group	Floor Size	Beds	Baths	Yr Blt	Eff Yr Blt	Inventory	
Building Structure	0	Finished	3200	0	0	2001	2001		Exception: Y N

Accessories					
Description	Class	Size SqFt	Eff Yr Blt	RMV	Quantity
No accessory data available					

Bldg: 21 ✓ Code Area: 05535 Stat Class: 354 Year Blt: 2005 Eff Year Blt: 2005 Sq.Ft: 720 % Complete: 100
 Desc: Lean-to Light (LTL) Dimensions: 18x40 RMV: 1870
 Func Obsc: 100 Econ %: 100 Other %: 100 Exception: 0 Adjust: Adjust RMV: 0

Floors									
Type	Class	Display Group	Floor Size	Beds	Baths	Yr Blt	Eff Yr Blt	Inventory	
Lean-to Light Duty	4	Finished	720	0	0	2005	2005		Exception: Y N

Accessories					
Description	Class	Size SqFt	Eff Yr Blt	RMV	Quantity
No accessory data available					

Bldg: 22 ✓ Code Area: 05535 Stat Class: 356 Year Blt: 1985 Eff Year Blt: 1985 Sq.Ft: 920 % Complete: 100
 Desc: Lean-to Excellent (LTE) Dimensions: 92x10 RMV: 2380
 Func Obsc: 100 Econ %: 100 Other %: 100 Exception: 0 Adjust: Adjust RMV: 0

Floors									
Type	Class	Display Group	Floor Size	Beds	Baths	Yr Blt	Eff Yr Blt	Inventory	
Lean-to Excellent	4	Finished	920	0	0	1985	1985		Exception: Y N

Accessories					
Description	Class	Size SqFt	Eff Yr Blt	RMV	Quantity
No accessory data available					

Bldg: 24 Code Area: 05535 Stat Class: 351 Year Blt: 1985 Eff Year Blt: 1985 Sq.Ft: 1500 ³³⁰⁰ % Complete: 100
 Desc: General Purpose Building (GB) ^{MS} Dimensions: ~~25x30~~ RMV: 11210
 Func Obsc: 100 Econ %: 100 Other %: 100 Exception: 0 Adjust: ^{110x30} Adjust RMV: 0

Floors									
Type	Class	Display Group	Floor Size	Beds	Baths	Yr Blt	Eff Yr Blt	Inventory	
General Purpose Bldg. ^{MS}	6	Finished	750	0	0	1985	1985		Exception: Y N
Finished Office	6	Finished	750	0	0	1985	1985	FAIR	Exception: Y N

Accessories					
Description	Class	Size SqFt	Eff Yr Blt	RMV	Quantity
No accessory data available					

Bldg: 25 Code Area: 05535 Stat Class: 305 Year Blt: Eff Year Blt: Sq.Ft: 0 % Complete: 100
 Desc: Tank/Silo/Bin Dimensions: RMV: 3380
 Func Obsc: 100 Econ %: 100 Other %: 100 Exception: 0 Adjust: Adjust RMV: 0

Floors									
Type	Class	Display Group	Floor Size	Beds	Baths	Yr Blt	Eff Yr Blt	Inventory	
No floor data available									

Accessories					
Description	Class	Size SqFt	Eff Yr Blt	RMV	Quantity
No accessory data available					

Bldg: 26 ✓ Code Area: 05535 Stat Class: 351 Year Blt: 1998 Eff Year Blt: 1998 Sq.Ft: 4040 % Complete: 100
 Desc: General Purpose Building (GB) Dimensions: RMV: 38830
 Func Obsc: 100 Econ %: 100 Other %: 100 Exception: 0 Adjust: Adjust RMV: 0

Floors									
Type	Class	Display Group	Floor Size	Beds	Baths	Yr Blt	Eff Yr Blt	Inventory	
General Purpose Bldg	5	Finished	4040	0	0	1998	1998	FAIR	Exception: Y N

Accessories					
Description	Class	Size SqFt	Eff Yr Blt	RMV	Quantity
No accessory data available					

Bldg: 27 ✓ Code Area: 05535 Stat Class: 354 Year Blt: 2009 Eff Year Blt: 2009 Sq.Ft: 640 % Complete: 100
 Desc: Lean-to Light (LTL) Dimensions: RMV: 1870
 Func Obsc: 100 Econ %: 100 Other %: 100 Exception: 0 Adjust: Adjust RMV: 0

Floors									
Type	Class	Display Group	Floor Size	Beds	Baths	Yr Blt	Eff Yr Blt	Inventory	
Lean-to Light Duty	6	Finished	640	0	0	2009	2009	Exception: Y N	

Accessories

Description	Class	Size SqFt	Eff Yr Blt	RMV	Quantity
No accessory data available					

Bldg: 28 ✓ Code Area: 05535 Stat Class: 332 Year Blt: 1973 Eff Year Blt: 1973 Sq.Ft: 19800 % Complete: 100
 Desc: Commercial Greenhouse (CG) Dimensions: RMV: 44000
 Func Obsc: 100 Econ %: 100 Other %: 100 Exception: 0 Adjust: Adjust RMV: 0

Floors									
Type	Class	Display Group	Floor Size	Beds	Baths	Yr Blt	Eff Yr Blt	Inventory	
Commerical Greenhouse	6	Finished	19800	0	0	1973	1973	Exception: Y N	

Accessories

Description	Class	Size SqFt	Eff Yr Blt	RMV	Quantity
No accessory data available					

Bldg: 29 ✓ Code Area: 05535 Stat Class: 332 Year Blt: 1975 Eff Year Blt: 1975 Sq.Ft: 21600 % Complete: 100
 Desc: Commercial Greenhouse (CG) Dimensions: RMV: 67200
 Func Obsc: 100 Econ %: 100 Other %: 100 Exception: 0 Adjust: Adjust RMV: 0

Floors									
Type	Class	Display Group	Floor Size	Beds	Baths	Yr Blt	Eff Yr Blt	Inventory	
Commerical Greenhouse	6	Finished	21600	0	0	1975	1987	Exception: Y N	

Accessories

Description	Class	Size SqFt	Eff Yr Blt	RMV	Quantity
No accessory data available					

Bldg: 30 ✓ Code Area: 05535 Stat Class: 332 Year Blt: 1975 Eff Year Blt: 1975 Sq.Ft: 21600 % Complete: 100
 Desc: Commercial Greenhouse (CG) Dimensions: RMV: 67200
 Func Obsc: 100 Econ %: 100 Other %: 100 Exception: 0 Adjust: Adjust RMV: 0

Floors									
Type	Class	Display Group	Floor Size	Beds	Baths	Yr Blt	Eff Yr Blt	Inventory	
Commerical Greenhouse	6	Finished	21600	0	0	1975	1987	Exception: Y N	

Accessories

Description	Class	Size SqFt	Eff Yr Blt	RMV	Quantity
No accessory data available					

Bldg: 31 ✓ Code Area: 05535 Stat Class: 332 Year Blt: 2006 Eff Year Blt: 2006 Sq.Ft: 23400 % Complete: 100
 Desc: Commercial Greenhouse (CG) Dimensions: RMV: 171590
 Func Obsc: 100 Econ %: 100 Other %: 100 Exception: 0 Adjust: Adjust RMV: 0

Floors									
Type	Class	Display Group	Floor Size	Beds	Baths	Yr Blt	Eff Yr Blt	Inventory	
Commerical Greenhouse	6	Finished	23400	0	0	2006	2006	Exception: Y N	

Accessories

Description	Class	Size SqFt	Eff Yr Blt	RMV	Quantity
No accessory data available					

Bldg: 32 ✓ Code Area: 05535 Stat Class: 332 Year Blt: 1975 Eff Year Blt: 1975 Sq.Ft: 23400 % Complete: 100
 Desc: Commercial Greenhouse (CG) Dimensions: RMV: 72800
 Func Obsc: 100 Econ %: 100 Other %: 100 Exception: 0 Adjust: Adjust RMV: 0

Floors									
Type	Class	Display Group	Floor Size	Beds	Baths	Yr Blt	Eff Yr Blt	Inventory	
Commerical Greenhouse	6	Finished	23400	0	0	1975	1987	Exception: Y N	


Accessories

Description	Class	Size SqFt	Eff Yr Blt	RMV	Quantity
No accessory data available					

Bldg: 33 ✓ Code Area: 05535 Stat Class: 332 Year Blt: 2002 Eff Year Blt: 2002 Sq.Ft: 2880 % Complete: 100
 Desc: Commercial Greenhouse (CG) Dimensions: RMV: 4530
 Func Obsc: 100 Econ %: 100 Other %: 100 Exception: 0 Adjust: Adjust RMV: 0

Floors									
---------------	--	--	--	--	--	--	--	--	--

Type	Class	Display Group	Floor Size	Beds	Baths	Yr Blt	Eff Yr Blt	Inventory
Commerical Greenhouse	4	Finished	2880	0	0	2002	2002	Exception: Y N
Accessories								
Description	Class	Size SqFt	Eff Yr Blt	RMV	Quantity			
No accessory data available								



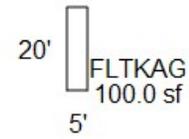


R36921
102W09 00100

FOR ASSESSMENT PURPOSES ONLY
DISTANCE BETWEEN BUILDINGS NOT TO SCALE

"SEE PAGE ONE FOR ALL BUILDINGS"
SCALE=1:65

Gas can shed


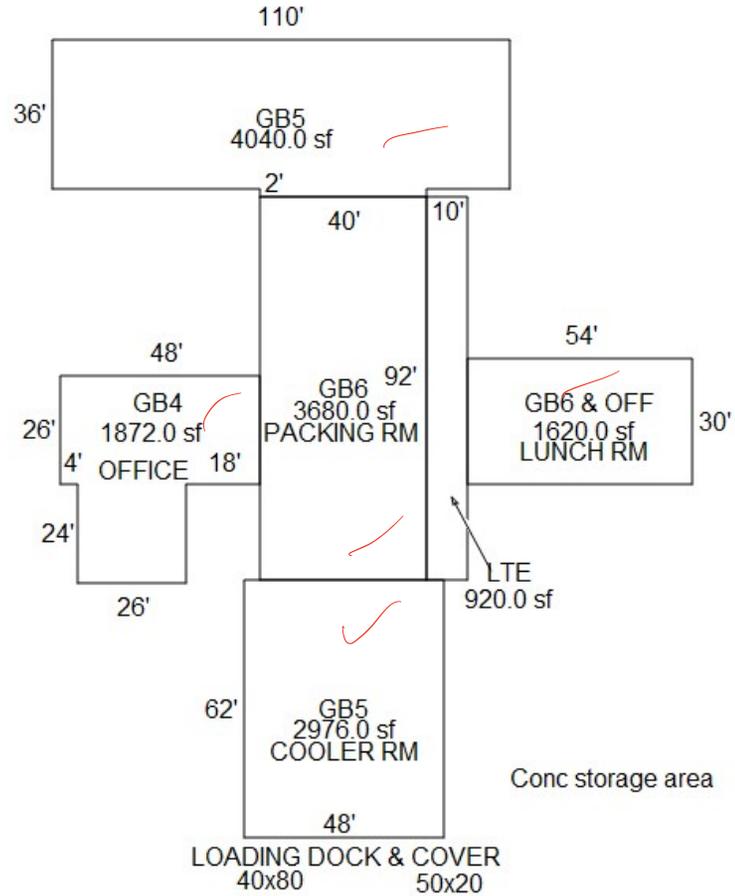
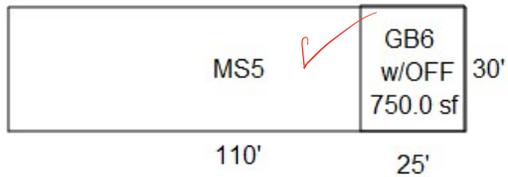
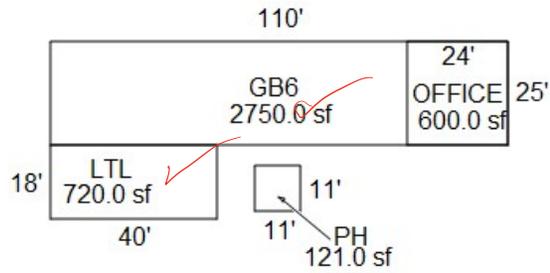


Conc storage area

Conc storage area

102W09 00100
R36921

"SEE PAGE ONE FOR ALL BUILDINGS"
 SCALE=1:115

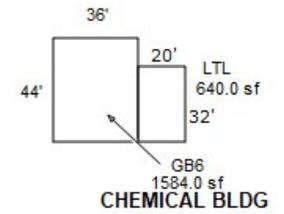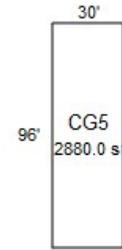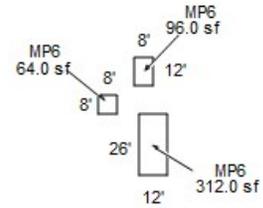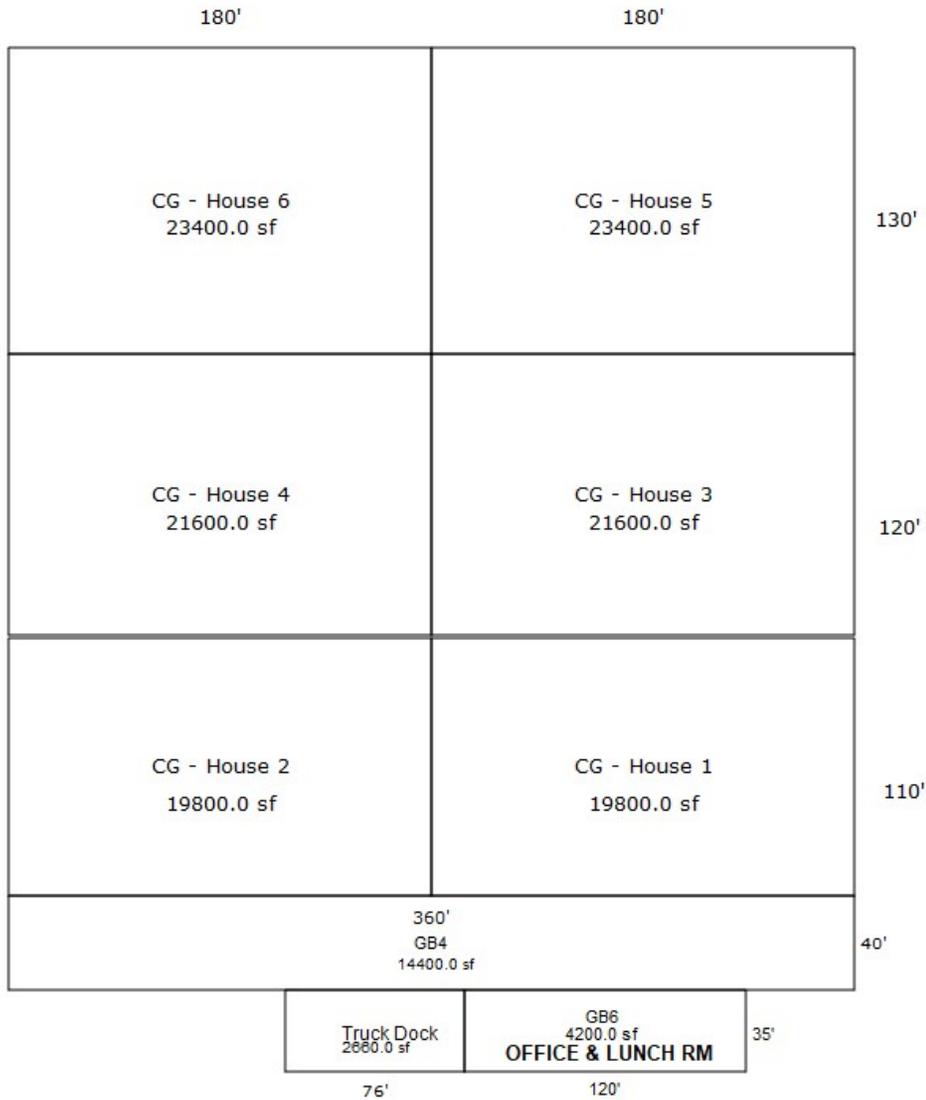


102W09 00100

R36921

"SEE PAGE ONE FOR ALL BUILDINGS"

SCALE=1:25

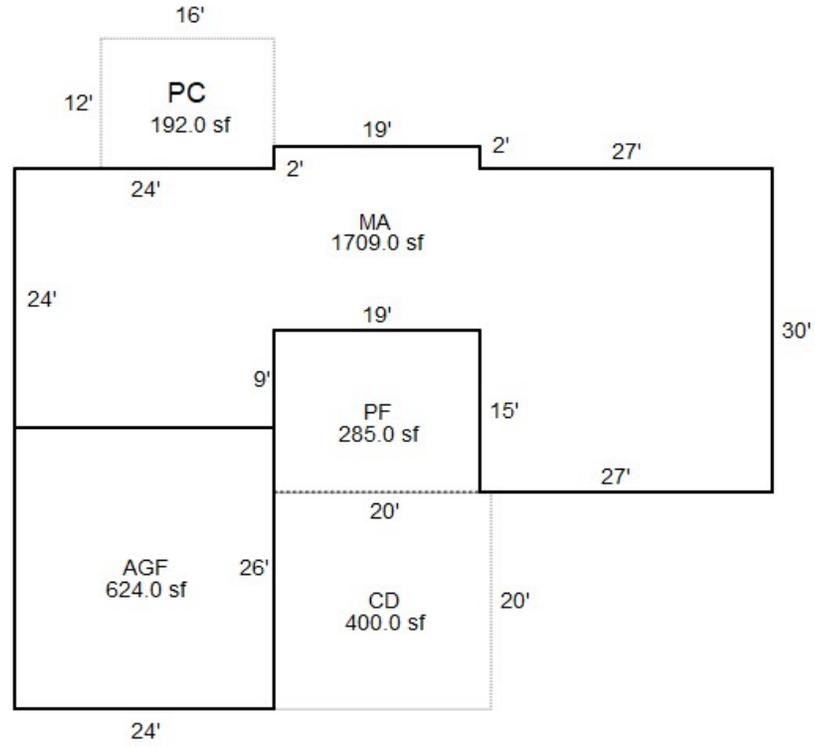



















DANGER
DIESEL

FLAMMABLE

NO SMOKING

DANGER
GASOLINE







