


# SKETCH/AREA TABLE ADDENDUM

## SUBJECT INFO

File No.: 596862 Parcel No.: 073W34AD00700  
 Property Address: 1108 LEWIS ST SE  
 City: SALEM County: Marion State: OR ZipCode: 97302  
 Owner:  
 Client: Client Address:  
 Appraiser Name: Inspection Date:

## SKETCH

**596862**  
**073W34AD00700**

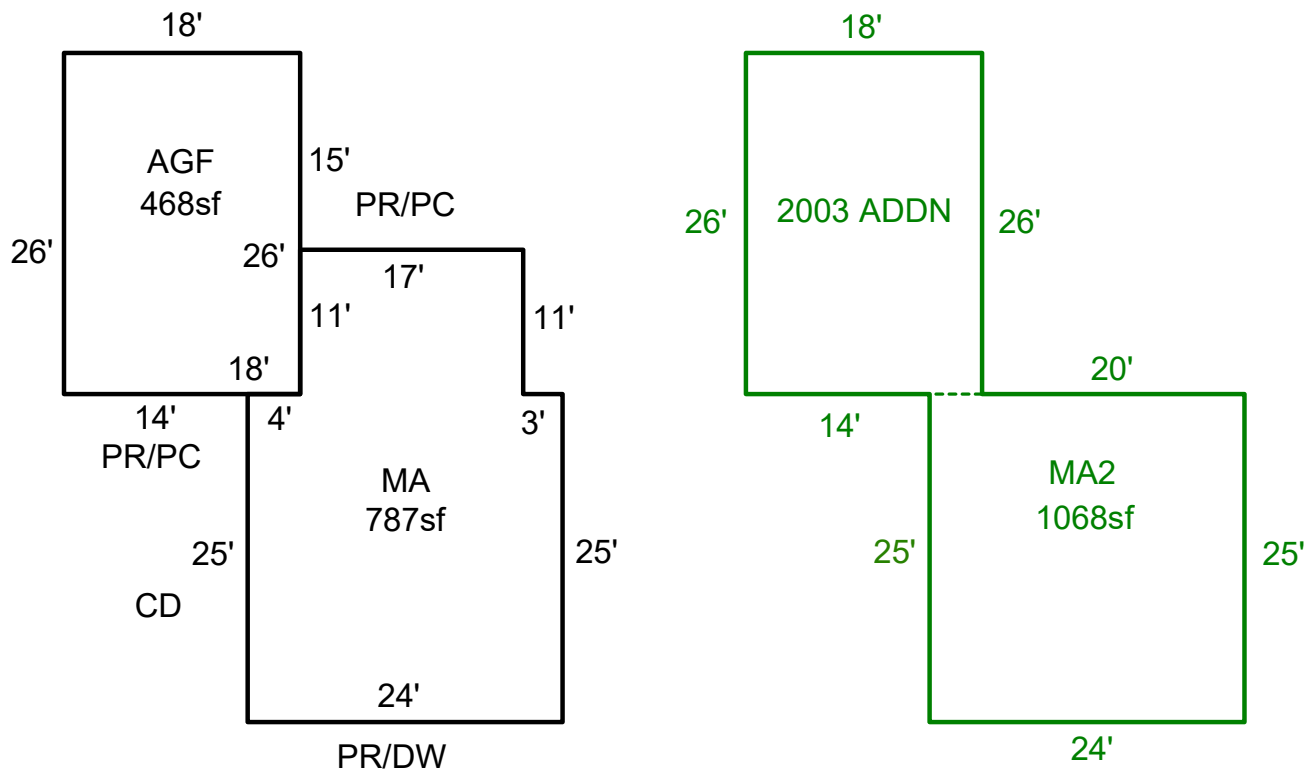

Sketch by ApexSketch

### AREA CALCULATIONS SUMMARY

Code	Description	Factor	Net Size	Perimeter	Net Totals
GLA	MA	1.0	787.0	120.0	787.0
GLA2	MA2	1.0	1068.0	178.0	1068.0
GAR	AGF	1.0	468.0	88.0	468.0

### COMMENT TABLE 1

DRAWN BY PT 2/09/2012  
 Updated by AE 7.30.25

### COMMENT TABLE 2

7/17/15 #72 NV-Cycle

### COMMENT TABLE 3

Net LIVABLE                      cnt                      2      (rounded)                      1,855