


SKETCH/AREA TABLE ADDENDUM

SUBJECT INFO

File No.: 102019	Parcel No.: 061W35CB08500		
Property Address: 407 S 1ST ST			
City: SILVERTON	County: Marion	State: OR	ZipCode: 97381
Owner:			
Client:		Client Address:	
Appraiser Name:		Inspection Date:	

SKETCH

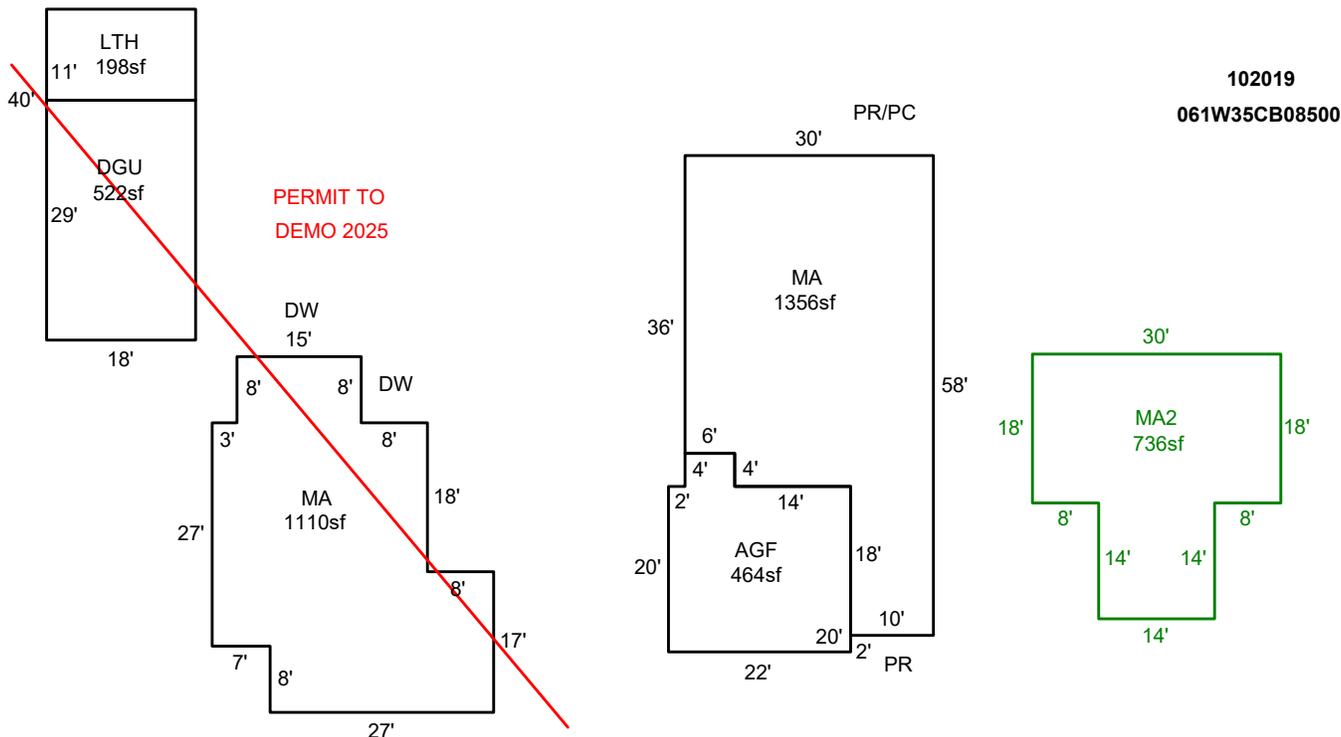

AREA CALCULATIONS SUMMARY

Code	Description	Factor	Net Size	Perimeter	Net Totals
GBA	LTH	1.0	198.0	58.0	198.0
GLA	MA	1.0	1110.0	154.0	
	MA	1.0	1356.0	176.0	2466.0
GLA2	MA2	1.0	736.0	124.0	736.0
GAR	DGU	1.0	522.0	94.0	
	AGF	1.0	464.0	92.0	986.0
Net LIVABLE		cnt	3 (rounded)		3,202
Net BUILDING		cnt	1 (rounded)		198

COMMENT TABLE 1

Drawn by Pat Long 05/04/2009
 UPDATED BY LK 4-13-18
 Updated by AE 9.12.25

COMMENT TABLE 2

4-3-18 101 CYCLE NV

COMMENT TABLE 3