


SKETCH/AREA TABLE ADDENDUM

SUBJECT INFO

File No.: 132448 Parcel No.: 091W020000700
 Property Address: 1521 FERN RIDGE RD SE #16
 City: STAYTON County: State: OR ZipCode: 97383
 Owner:
 Client: Client Address:
 Appraiser Name: Inspection Date:

SKETCH

132448
091W020000700

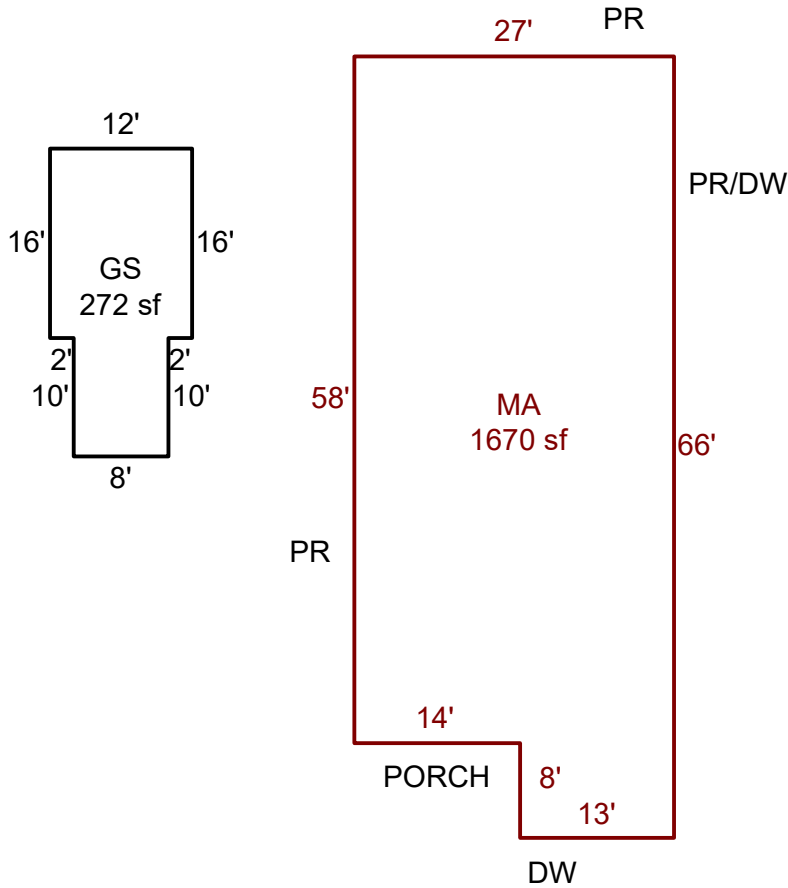

Sketch by ApexSketch

AREA CALCULATIONS SUMMARY

Code	Description	Factor	Net Size	Perimeter	Net Totals
GBA	GS	1.0	272.0	76.0	272.0
MFH	MA	1.0	1670.0	186.0	1670.0

COMMENT TABLE 1

DRAWN BY LK 9.11.25

COMMENT TABLE 2

3.18.25 SV TS

COMMENT TABLE 3

Net LIVABLE	cnt	1	(rounded)		1,670
Net BUILDING	cnt	1	(rounded)		272