


SKETCH/AREA TABLE ADDENDUM

SUBJECT INFO

File No.: 328500 Parcel No.: 082W02C 06200
 Property Address: 7454 HARLEY WY SE
 City: Salem County: Marion State: OR ZipCode: 97317
 Owner:
 Client: Client Address:
 Appraiser Name: Inspection Date:

SKETCH

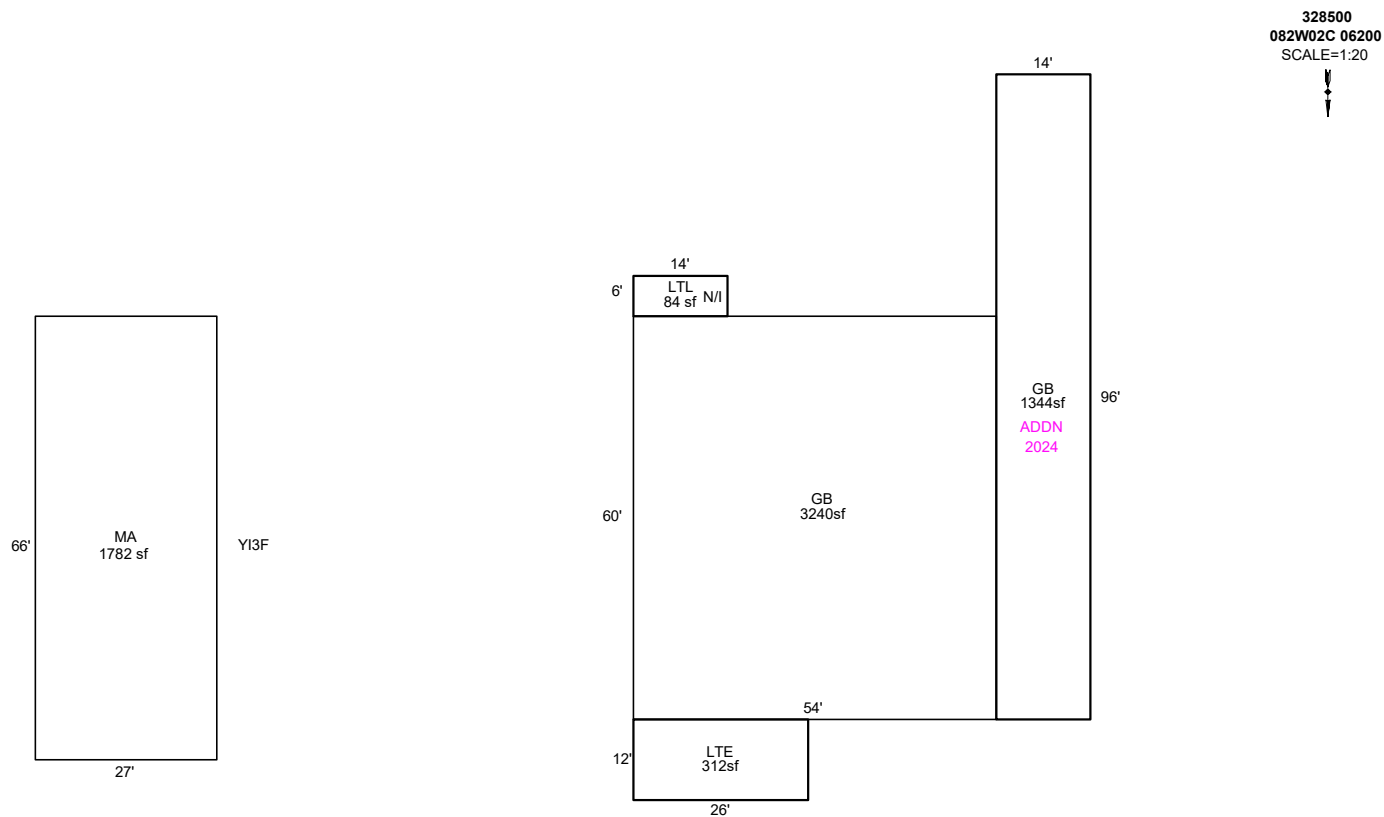

Sketch by ApexSketch

AREA CALCULATIONS SUMMARY

Code	Description	Factor	Net Size	Perimeter	Net Totals
GBA1	GB	1.0	3240.0	228.0	
	LTE	1.0	312.0	76.0	
	GB	1.0	1344.0	220.0	4896.0
GLA1	MA	1.0	1782.0	186.0	1782.0

COMMENT TABLE 1

DRAWN BY JRONDEMA 2/15/18
 UPDATED BY CJURAN 01/25/2021 555-20-007812
 UPDATED BY CLOBERG 08/21/24 24-004385 ADDN
 UPDATED BY CLOBERG 01/14/25
 UPDATED BY CLOBERG 10/15/25

COMMENT TABLE 2

CLUKE 12/17/24
 CLUKE

COMMENT TABLE 3

TAGS L3
 TAGS L4

Net LIVABLE	cnt	0	(rounded)	1,782
Net BUILDING	cnt	3	(rounded)	4,896