


SKETCH/AREA TABLE ADDENDUM

SUBJECT INFO

File No.: 105880 Parcel No.: 082W29AB02800
 Property Address: 7130 2nd St SE/7130 2nd St SE Unit A
 City: Turner County: Marion State: OR ZipCode: 97392
 Owner:
 Client: Client Address:
 Appraiser Name: Inspection Date:

SKETCH

105880
082W29AB02800

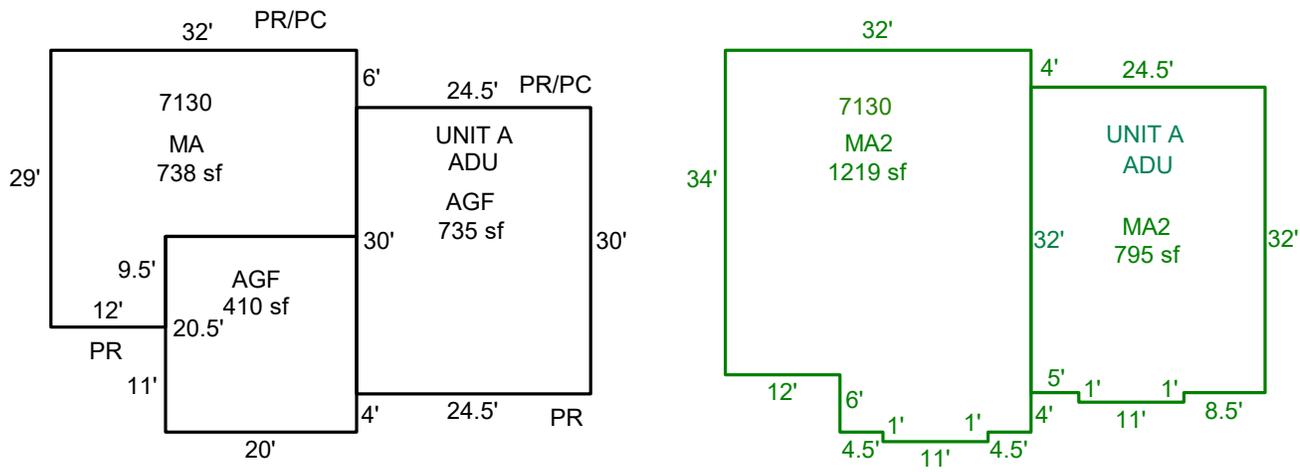

Sketch by ApexSketch

AREA CALCULATIONS SUMMARY						COMMENT TABLE 1	
Code	Description	Factor	Net Size	Perimeter	Net Totals		
GLA	MA	1.0	738.0	122.0	738.0	Drawn by AE 6.17.25 UPDATED BY LK 10.29.25	
GLA2	MA2	1.0	1219.0	146.0			
	MA2	1.0	795.0	115.0	2014.0		
GAR	AGF	1.0	410.0	81.0			
	AGF	1.0	735.0	109.0	1145.0		
						COMMENT TABLE 2	COMMENT TABLE 3
						10.14.25 TAG GM	
Net LIVABLE		cnt	3 (rounded)		2,752		