



SKETCH/AREA TABLE ADDENDUM

SUBJECT INFO

File No.: 595288 Parcel No.: 073W26CB00100
 Property Address: 525 15th St SE/525 15th St SE Unit A
 City: Salem County: Marion State: OR ZipCode: 97301
 Owner:
 Client: Client Address:
 Appraiser Name: Inspection Date:

SKETCH

595288
073W26CB00100

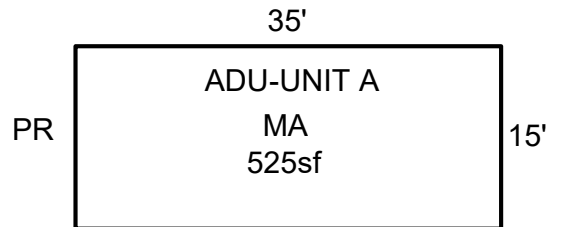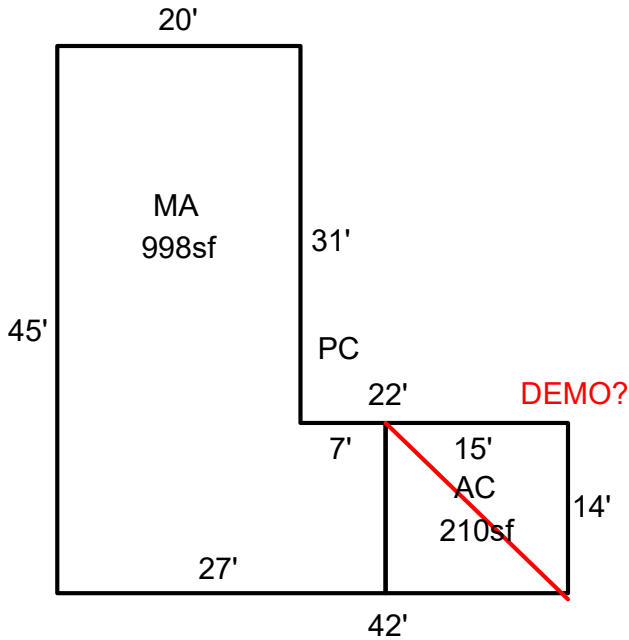

Sketch by ApexSketch

AREA CALCULATIONS SUMMARY

Code	Description	Factor	Net Size	Perimeter	Net Totals
GLA	MA	1.0	998.0	144.0	
	MA	1.0	525.0	100.0	1523.0
GAR	AC	1.0	210.0	58.0	210.0

COMMENT TABLE 1

DRAWN BY AMB 03-16-11
 Updated by AE 10.23.25

COMMENT TABLE 2

8-15-05 JP32 NV-Recalc

COMMENT TABLE 3

Net LIVABLE cnt 2 (rounded) 1,523