


# SKETCH/AREA TABLE ADDENDUM

## SUBJECT INFO

File No.: 611832 Parcel No.: 062W36 00601  
 Property Address: 8954 HAZELGREEN RD NE  
 City: SILVERTON County: MARION State: OR ZipCode: 97381  
 Owner:  
 Client: Client Address:  
 Appraiser Name: Inspection Date:

## SKETCH

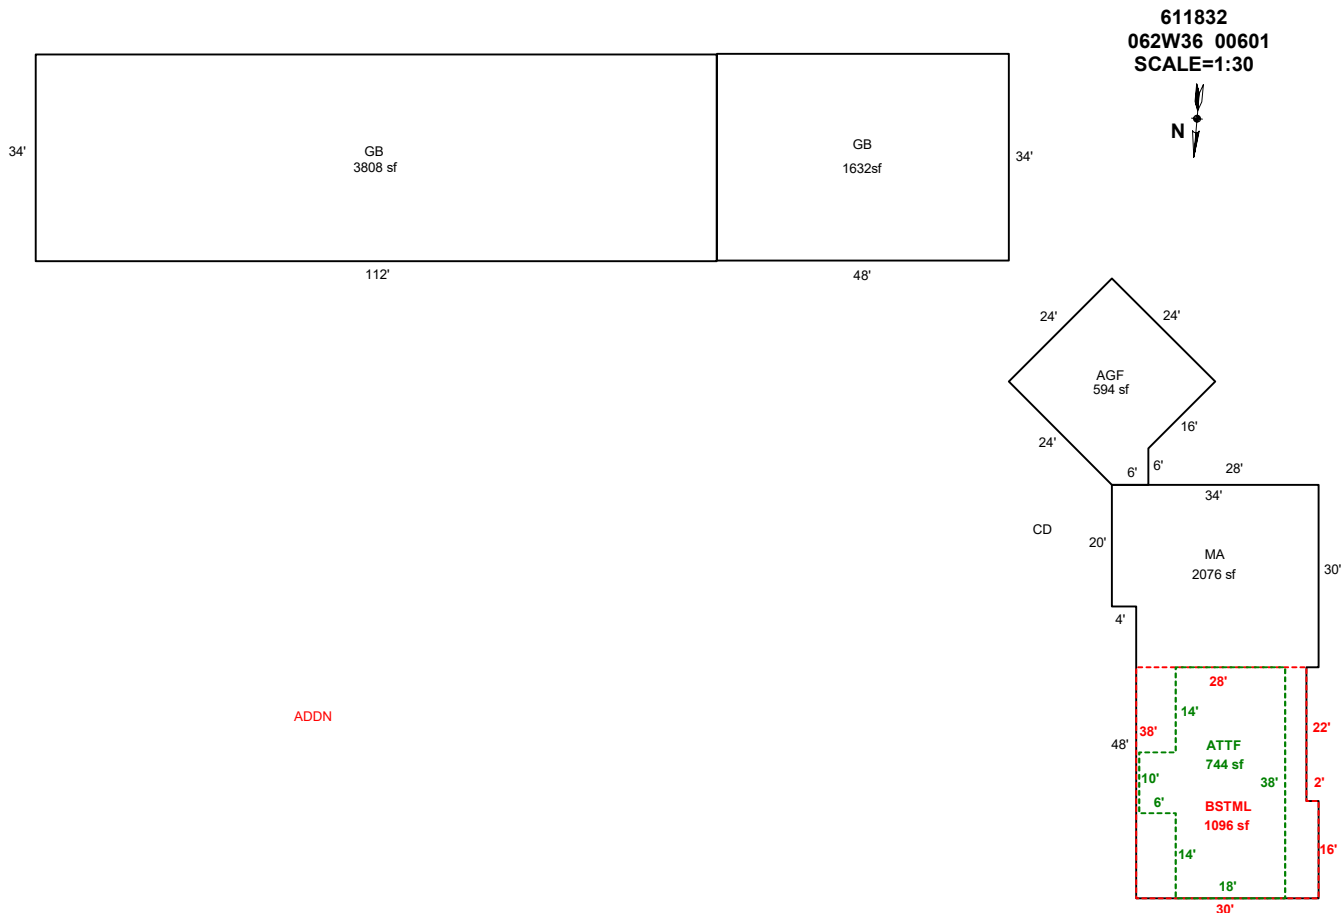

Sketch by ApexSketch

### AREA CALCULATIONS SUMMARY

| Code | Description | Factor | Net Size | Perimeter | Net Totals |
|------|-------------|--------|----------|-----------|------------|
| GBA1 | GB          | 1.0    | 3808.0   | 292.0     |            |
|      | GB          | 1.0    | 1632.0   | 164.0     | 5440.0     |
| GLA0 | BSTML       | 1.0    | 1096.0   | 136.0     | 1096.0     |
| GLA1 | MA          | 1.0    | 2076.0   | 208.0     | 2076.0     |
| GLA2 | ATTFF       | 1.0    | 744.0    | 124.0     | 744.0      |
| GAR  | AGF         | 1.0    | 594.0    | 99.5      | 594.0      |

### COMMENT TABLE 1

UPDATED BY WWILLIAMS 9/29/25  
 UPDATED BY WWILLIAMS 11/10/25

### COMMENT TABLE 2

5/12/25 MLH  
 10/2/25 MLH

### COMMENT TABLE 3

WO L4  
 SV L4

Net LIVABLE cnt 2 (rounded) 3,916  
 Net BUILDING cnt 2 (rounded) 5,440