


# SKETCH/AREA TABLE ADDENDUM

| SUBJECT INFO                    |                  |                           |                |
|---------------------------------|------------------|---------------------------|----------------|
| File No.: 101503                |                  | Parcel No.: 061E22AB02000 |                |
| Property Address: 470 SCOTTS AV |                  |                           |                |
| City: SCOTTS MILLS              | County: Marion   | State: OR                 | ZipCode: 97375 |
| Owner:                          |                  |                           |                |
| Client:                         | Client Address:  |                           |                |
| Appraiser Name:                 | Inspection Date: |                           |                |

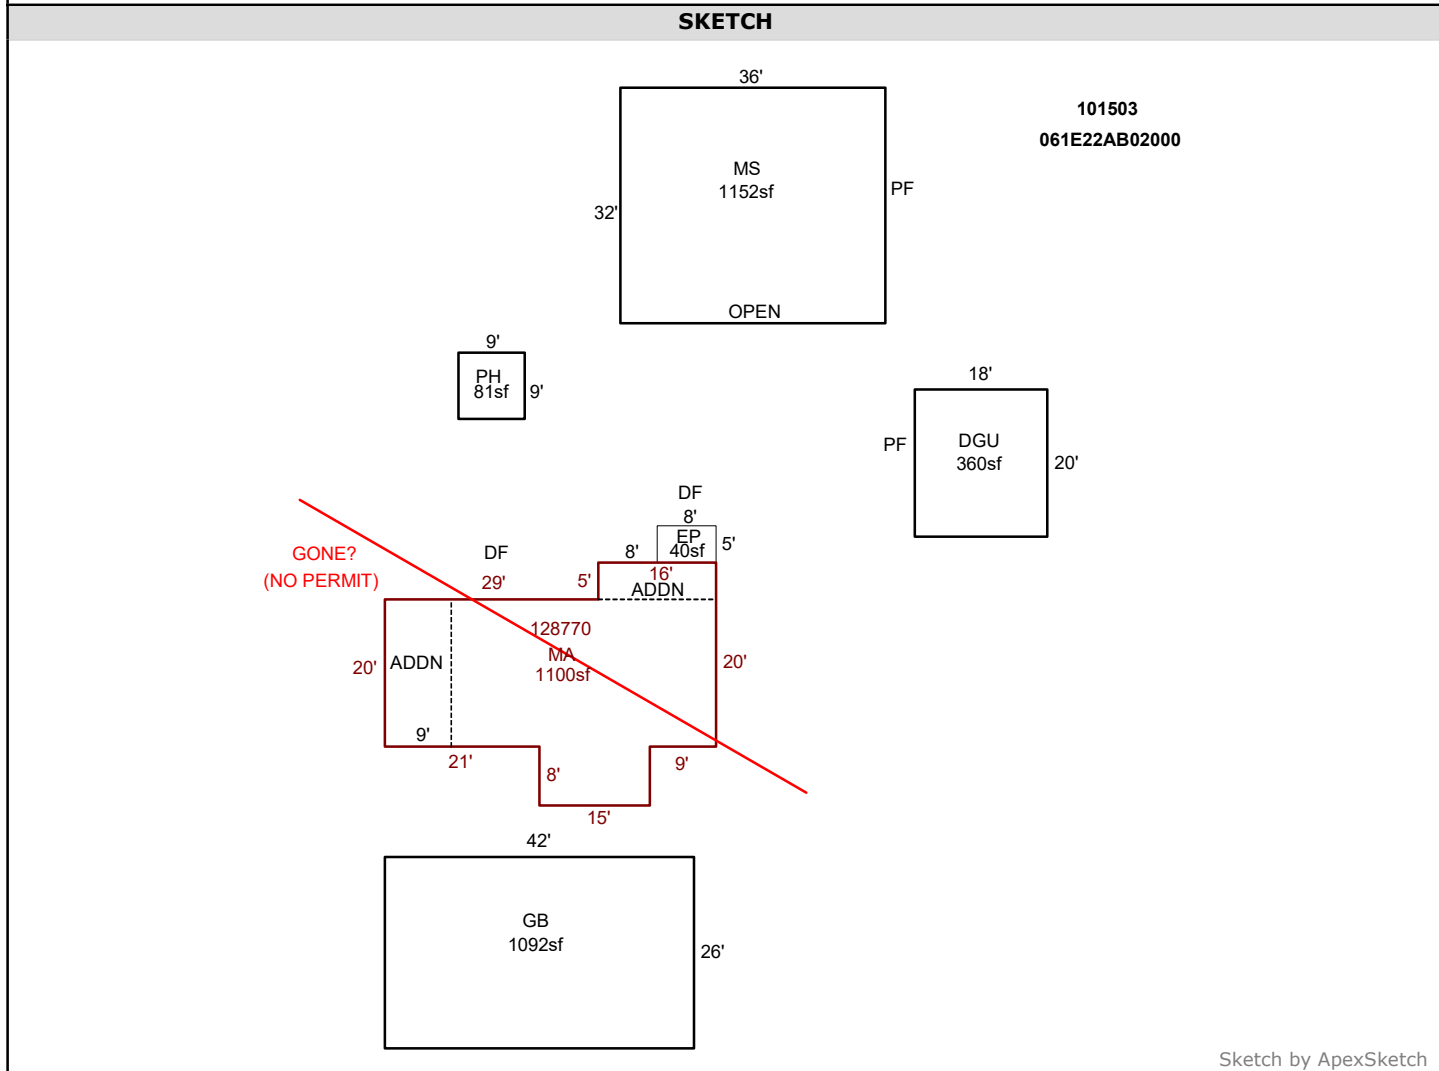

Sketch by ApexSketch

| AREA CALCULATIONS SUMMARY |             |        |          |           |            | COMMENT TABLE 1                                      |                 |
|---------------------------|-------------|--------|----------|-----------|------------|------------------------------------------------------|-----------------|
| Code                      | Description | Factor | Net Size | Perimeter | Net Totals | Drawn By: slong-01/14/2010<br>Updated by AE 11.12.25 |                 |
| GBA                       | MS          | 1.0    | 1152.0   | 136.0     |            |                                                      |                 |
|                           | GB          | 1.0    | 1092.0   | 136.0     | 2244.0     |                                                      |                 |
| GBA1                      | PH          | 1.0    | 81.0     | 36.0      | 81.0       |                                                      |                 |
| GAR                       | DGU         | 1.0    | 360.0    | 76.0      | 360.0      |                                                      |                 |
| MFH                       | MA          | 1.0    | 1100.0   | 156.0     | 1100.0     |                                                      |                 |
| P/P                       | EP          | 1.0    | 40.0     | 26.0      | 40.0       |                                                      |                 |
|                           |             |        |          |           |            | COMMENT TABLE 2                                      | COMMENT TABLE 3 |
|                           |             |        |          |           |            | 9-1-17 96 Cycle NV<br>6/7/19 #24 SV NV               |                 |
| Net LIVABLE               |             | cnt    | 1        | (rounded) | 1,100      |                                                      |                 |
| Net BUILDING              |             | cnt    | 2        | (rounded) | 2,325      |                                                      |                 |