

Rural Work Order Cover Sheet

RAM Transaction #: 640382

Year: 25 - 26

Account Numbers Involved: 534595 611435

Sequence #1: SIZE CORRECTION 534595 -0.05

Sequence #2: PARTITION PLAT PER MARION COUNTY PARTITION CASE 2023-004 611435 SEGREGATED OUT OF
534595. -37.07 534595

Sequence #3: PARTITION PLAT PER MARION COUNTY PARTITION CASE 2023-004 611435 SEGREGATED OUT OF
534595. +37.07 611435

Sequence #4: _____

Sequence #5: _____

		Check For:				Forms Included:	
	Yes	No		Yes	No		✓
Move Building Permits	☐	☒	Fire Patrol	☒	☐	RAM Report	☒
Move Photos	☐	☒	Multi-Section	☐	☒	Processing Forms	☒
Update Apex	☐	☒	Tagged for 2 nd year Reset	☐	☒	Before and After Maps	☒
Update Account Notes	☒	☐	Exemptions	☐	☒	Multi-Section Processing Form	☐
PAT LIAB	☐	☒	Update Tracker	☒	☐	Calculation Form(s)	☐

Miscellaneous Notes: UNIT OK -- REMOVE TOPO ADJUSTMENT FROM 534595

AFTER WORK ORDER – 611435 MOVE 0.37 FROM 2HD INTO WOODLOT

Appraiser: WW

Date: 3.10.25

Appraisal Review: WW

Date: 3.10.25

Data Entry: Chin

Date: 4/9/25

Tax Year	Account ID	MTL	Transaction	Voucher Sequence	Recorded Date	Operation	Voucher Notes	Code	+/- Size	Size Type
2025	534595	091W11A000400	640382	1	9/3/2024 12:08	SIZE CHANGE	SIZE CORRECTION	29540	-0.05	A
2025	534595	091W11A000400	640382	2	9/3/2024 12:08	PARTITION PLAT - FROM	PARTITION PLAT PER MARION COUNTY PARTITION CASE 2023-004. 611435 SEGREGATED OUT OF 534595	29540	-37.07	A
2025	611435	091W11A000402	640382	3	9/3/2024 12:08	PARTITION PLAT - TO	PARTITION PLAT PER MARION COUNTY PARTITION CASE 2023-004. 611435 SEGREGATED OUT OF 534595	29540	37.07	A

Rural Work Order Processing Form

One Page Per Account

Sequence #: 1 of 3 Account Number: 534595 MTL: 091W11A000400 RAM Transaction ID: 640382

Type: ☐ COM ☐ LLA ☐ PPT ☐ SEG ☐ SUB ☒ AC ☐ R of W ☐ Vacate ☐ Map Maintenance

Account Details

Ma Sa Nh: 01 06 000 Prop Class: 550 RMV Class: 500

Assigned Appraiser: CLUKE Part of Unit: Yes ☒ or No ☐ Fire Patrol: Yes ☒ or No ☐

Land Fragment

Account From	Code Area	Liab Yr	Land Class	LUC	Value Source	# of Acres	Zone	Land Adjustments
534595	29540	1980	2HD	005	FARM USE EFU	33.33	UT	GSOIL
534595	29540	1980	4HD	005	FARM USE EFU	40.00	UT	
534595	29540	1980	4HD	005	WOODLOT	2.70	UT	

Total Acres: 76.03

Improvements

Account From	Code Area	Imp ID	Stat Class	Description	Account From	Code Area	Imp ID	Stat Class	Description

Adjustments: _____

Exception

New MAV: _____ ☐ Sys Calc ☒ No Change to MAV

Rural Work Order Processing Form

One Page Per Account

Sequence #: 2 of 3 Account Number: 534595 MTL: 091W11A000400 RAM Transaction ID: 640382

Type: ☐ COM ☐ LLA ☒ PPT ☐ SEG ☐ SUB ☐ AC ☐ R of W ☐ Vacate ☐ Map Maintenance

Account Details

Ma Sa Nh: 01 06 000 Prop Class: 550 RMV Class: 500

Assigned Appraiser: CLUKE Part of Unit: Yes ☒ or No ☐ Fire Patrol: Yes ☒ or No ☐

Land Fragment

Account From	Code Area	Liab Yr	Land Class	LUC	Value Source	# of Acres	Zone	Land Adjustments
534595	29540	1980	4HD	005	FARM USE EFU	36.26	UT	
534595	29540	1980	4HD	005	WOODLOT	2.70	UT	

Total Acres: 38.96

Improvements

Account From	Code Area	Imp ID	Stat Class	Description	Account From	Code Area	Imp ID	Stat Class	Description

Adjustments: _____

Exception

New MAV: _____ ☐ Sys Calc ☒ No Change to MAV

Rural Work Order Processing Form

One Page Per Account

Sequence #: 3 of 3 Account Number: 611435 MTL: 091W11A000402 RAM Transaction ID: 640382

Type: ☐ COM ☐ LLA ☒ PPT ☐ SEG ☐ SUB ☐ AC ☐ R of W ☐ Vacate ☐ Map Maintenance

Account Details

Ma Sa Nh: 01 06 000 Prop Class: 550 RMV Class: 500

Assigned Appraiser: CLUKE Part of Unit: Yes ☒ or No ☐ Fire Patrol: Yes ☒ or No ☐

Land Fragment

Account From	Code Area	Liab Yr	Land Class	LUC	Value Source	# of Acres	Zone	Land Adjustments
534595	29540	1980	2HD	005	FARM USE EFU	17.55	UT	GSOIL
534595	29540	1980	4HD	005	FARM USE EFU	19.52	UT	

Total Acres: 37.07

Improvements

Account From	Code Area	Imp ID	Stat Class	Description	Account From	Code Area	Imp ID	Stat Class	Description

Adjustments: _____

Exception

New MAV: _____ ☐ Sys Calc ☒ No Change to MAV

09 1W 11A
STAYTON



MARION COUNTY, OREGON
NE1/4 SEC11 T9S R1W W.M.
SCALE 1" = 200'

LEGEND

LINE TYPES

- Historical Boundary
- Experiment
- Railroad Right-of-Way
- Railroad Centerline
- Private Road ROW
- Subdivision Plat Boundary
- Waterline - Treated
- Waterline - Non Treated

CORNER TYPES

- + 1/16th Section Cor
- ⊕ 1/4 Corner
- ⊕ 1/4 Section Cor
- ⊕ 1/4 Section Corner
- ⊕ 1/4 Section Corner

NUMBERS

Tax Code Number
00 00 0

All areas listed are Net Acres, excluding any
portions of the total within public ROWs

NOTES

Tick Marks: A tick mark in the road indicates that the
labelled dimension extends into the public ROW

CANCELLED NUMBERS

000


DISCLAIMER: THIS MAP WAS PREPARED
FOR ASSESSMENT PURPOSES ONLY



FOR ADDITIONAL MAPS VISIT OUR WEBSITE AT
www.co.marion.or.us

PLOT DATE: 10/17/2020

STAYTON
09 1W 11A

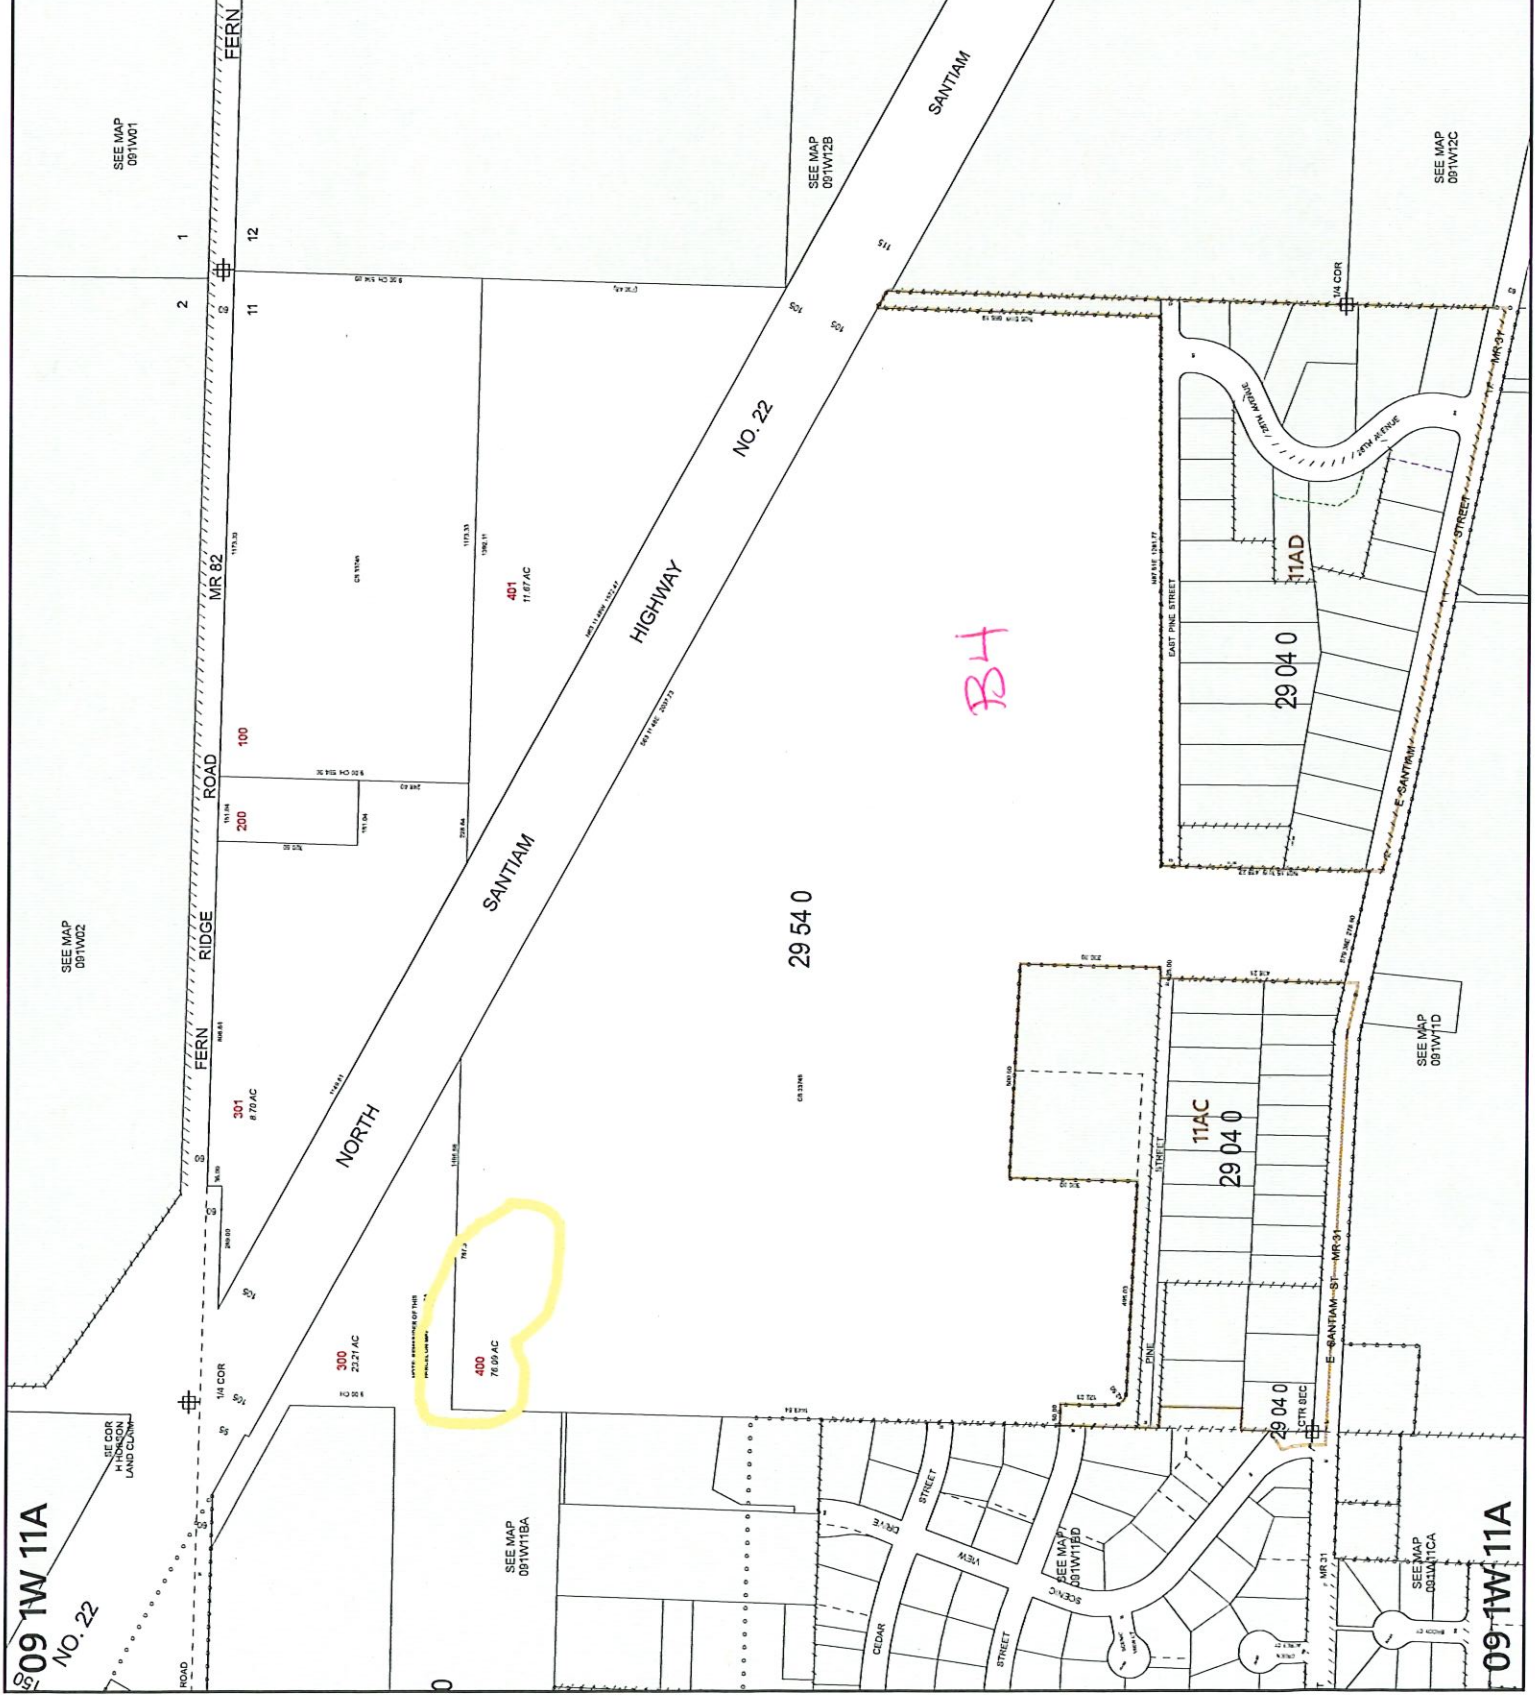

09 1W 11A

09-1W-11A



MARION COUNTY, OREGON
NE1/4 SEC11 T9S R1W W.M.

SCALE 1" = 200'

LEGEND

- | | | |
|------------------------------|-------|--------------------------|
| LINE TYPES | | |
| <u>Taxlot Boundary</u> | ----- | Historical Boundary |
| <u>Road Right-of-Way</u> | ----- | Easement |
| <u>Railroad Right-of-Way</u> | ----- | Railroad Centerline |
| Private Road ROW | ----- | Taxcode Line |
| Subdivision/Plat Boundary | ----- | Map Boundary |
| Waterline - Taxlot Boundary | ----- | Waterline - Non Boundary |
| CORNER TYPES | | |
| + 1/16TH Section Cor. | + | 1/4 Section Cor. |
| © D/C Corner | © | Section Corner |
| | 16 15 | 21 22 |

NUMBERS
Tax Code Number
00 00 0

Acres
0.25 AC

NOTES

Tick Marks: A tick mark in the road indicates that the labeled dimension extends into the public ROW

CANCELLED NUMBERS

500

DISCLAIMER: THIS MAP WAS PREPARED
FOR ASSESSMENT PURPOSES ONLY



Assessors Office
Cartography Dept

FOR ADDITIONAL MAPS VISIT OUR WEBSITE AT
www.co.marion.or.us

PLOT DATE: 3/6/2025

