

Rural Work Order Cover Sheet

RAM Transaction #: 642409 Recording Date: _____ Year: 25 - 26

Account Numbers Involved: 516970, 516968

(New accounts in **Green**, Cancelled accounts in **Red**)

Sequence #1: ADJUSTMENT FROM 516970 TO 516968 -0.16

Sequence #2: ADJUSTMENT FROM 516970 TO 516968 +0.16

Sequence #3: ADJUSTMENT FROM 516968 TO 516970 -0.16

Sequence #4: ADJUSTMENT FROM 516968 TO 516970 +0.16

Sequence #5: _____

Sequence #6: _____

		Check For:			
	Yes	No		Yes	No
Move Building Permits	☐	☒	Multi-Section	☐	☒
Move Photos	☐	☒	Tagged for 2 nd year Reset	☐	☒
Update Apex	☐	☒	Exemptions	☐	☒
Update Account Notes	☐	☐	Update Tracker	☐	☐
PAT LIAB Updates	☐	☐			

Forms Included:		✓
RAM Report	☒	
Processing Forms	☒	
Before and After Maps	☒	
Multi-Section Processing Form	☐	
Calculation Form(s)	☐	

Miscellaneous Notes: Recording Date 9/16/2024

WW - FOLLOW UP WORKFLOW FOR INVENTORY CORRECTIONS BOTH ACCOUNTS

Forms Completed By: MLH

Date: 3/18/25

Appraisal Review: WW

Date: 3.19.25

Data Entry: CWD

Date: 4/17/25

Tax Year	Account ID	MTL	Transaction	Voucher Sequence	Recorded Date	Operation	Voucher Notes	Code	+/- Size	Size Type
2025	516970	061W33D000200	642409	1	9/16/2024 15:35	LOT LINE ADJUSTMENT - FROM	ADJUSTMENT FROM 516970 TO 516968	04500	-0.16	A
2025	516968	061W33D000800	642409	2	9/16/2024 15:35	LOT LINE ADJUSTMENT - TO	ADJUSTMENT FROM 516970 TO 516968	04500	0.16	A
2025	516968	061W33D000800	642409	3	9/16/2024 15:35	LOT LINE ADJUSTMENT - FROM	ADJUSTMENT FROM 516968 TO 516970	04500	-0.16	A
2025	516970	061W33D000200	642409	4	9/16/2024 15:35	LOT LINE ADJUSTMENT - TO	ADJUSTMENT FROM 516968 TO 516970	04500	0.16	A

One Page Per Account

Type: ☐ COM ☒ LLA ☐ PPT ☐ SEG ☐ SUB ☐ AC ☐ R of W ☐ Vacate ☐ Map Maintenance

Ma Sa Nh: 30 06 000 **Prop Class:** 551 **RMV Class:** 501 **Part of Unit:** Yes ☒ or No ☐

<u>Account From</u>	<u>Code Area</u>	<u>Liab Yr</u>	<u>Land Class</u>	<u>LUC</u>	<u>Value Source</u>	<u># of Acres</u>	<u>Zone</u>	<u>Land Adjustments</u>
516970	04500	2009	2BI	005	Farm Homesite	1.00	REST	GSOIL
516970	04500	1980	2BI	005	Farm Use- EFU	19..34	REST	GSOIL, IRR
516970	04500	1980	4BI	005	Farm Use- EFU	4.00	REST	IRR
516970	04500	1980	WST	005	Farm Use- EFU	0.81	REST	WASTE
					NO OSD CHANGE			

Improvements					
<u>Account From</u>	<u>Code Area</u>	<u>Imp ID</u>	<u>Stat Class</u>	<u>Description & Size</u>	
				NO CHANGES	

Exception

New MAV: ☐ Sys Calc ☒ No Change to MAV

One Page Per Account

Type: ☐ COM ☒ LLA ☐ PPT ☐ SEG ☐ SUB ☐ AC ☐ R of W ☐ Vacate ☐ Map Maintenance

Ma Sa Nh: 03 06 000 **Prop Class:** 551 **RMV Class:** 451 **Part of Unit:** Yes ☐ or No ☒

<u>Account From</u>	<u>Code Area</u>	<u>Liab Yr</u>	<u>Land Class</u>	<u>LUC</u>	<u>Value Source</u>	<u># of Acres</u>	<u>Zone</u>	<u>Land Adjustments</u>
516968	04500	2009	2BD	005	Farm Homesite	1.00	REST	GSOIL
516968	04500	1980	2BI	005	Farm Use- EFU	5.72	REST	GSOIL, IRR
516968	04500	1980	4BI	005	Farm Use- EFU	1.00	REST	IRR
516970	04500	1980	2BI	005	Farm Use- EFU	0.16	REST	GSOIL, IRR
					NO OSD CHANGE			

[illegible]

Exception

New MAV: ☐ Sys Calc ☒ No Change to MAV

Rural Work Order Processing Form

One Page Per Account

Sequence #: 4 of 4 Account Number: 516970 MTL: 516970 RAM Transaction ID: 642409

Type: ☐ COM ☒ LLA ☐ PPT ☐ SEG ☐ SUB ☐ AC ☐ R of W ☐ Vacate ☐ Map Maintenance

Account Details

Ma Sa Nh: 03 06 000 Prop Class: 551 RMV Class: 501 Part of Unit: Yes ☒ or No ☐

Land Fragment

<u>Account From</u>	<u>Code Area</u>	<u>Liab Yr</u>	<u>Land Class</u>	<u>LUC</u>	<u>Value Source</u>	<u># of Acres</u>	<u>Zone</u>	<u>Land Adjustments</u>
516970	04500	2009	2BI	005	Farm Homesite	1.00	REST	GSOIL
516970	04500	1980	2BI	005	Farm Use- EFU	19..34	REST	GSOIL, IRR
516970	04500	1980	4BI	005	Farm Use- EFU	4.00	REST	IRR
516970	04500	1980	WST	005	Farm Use- EFU	0.81	REST	WASTE
516968	04500	1980	2BI	005	Farm Use- EFU	0.16	REST	GSOIL, IRR
					NO OSD CHANGE			

Acreage Balance	Beginning Acres:	25.15	Ending Acres:	25.31	Net Gained or Lost:	0.16
------------------------	-------------------------	-------	----------------------	-------	----------------------------	------

■ Improvements

[illegible]


Adjustments:

Exception

New MAV: ☐ Sys Calc ☒ No Change to MAV

06 1W 33D

06 1W 33D

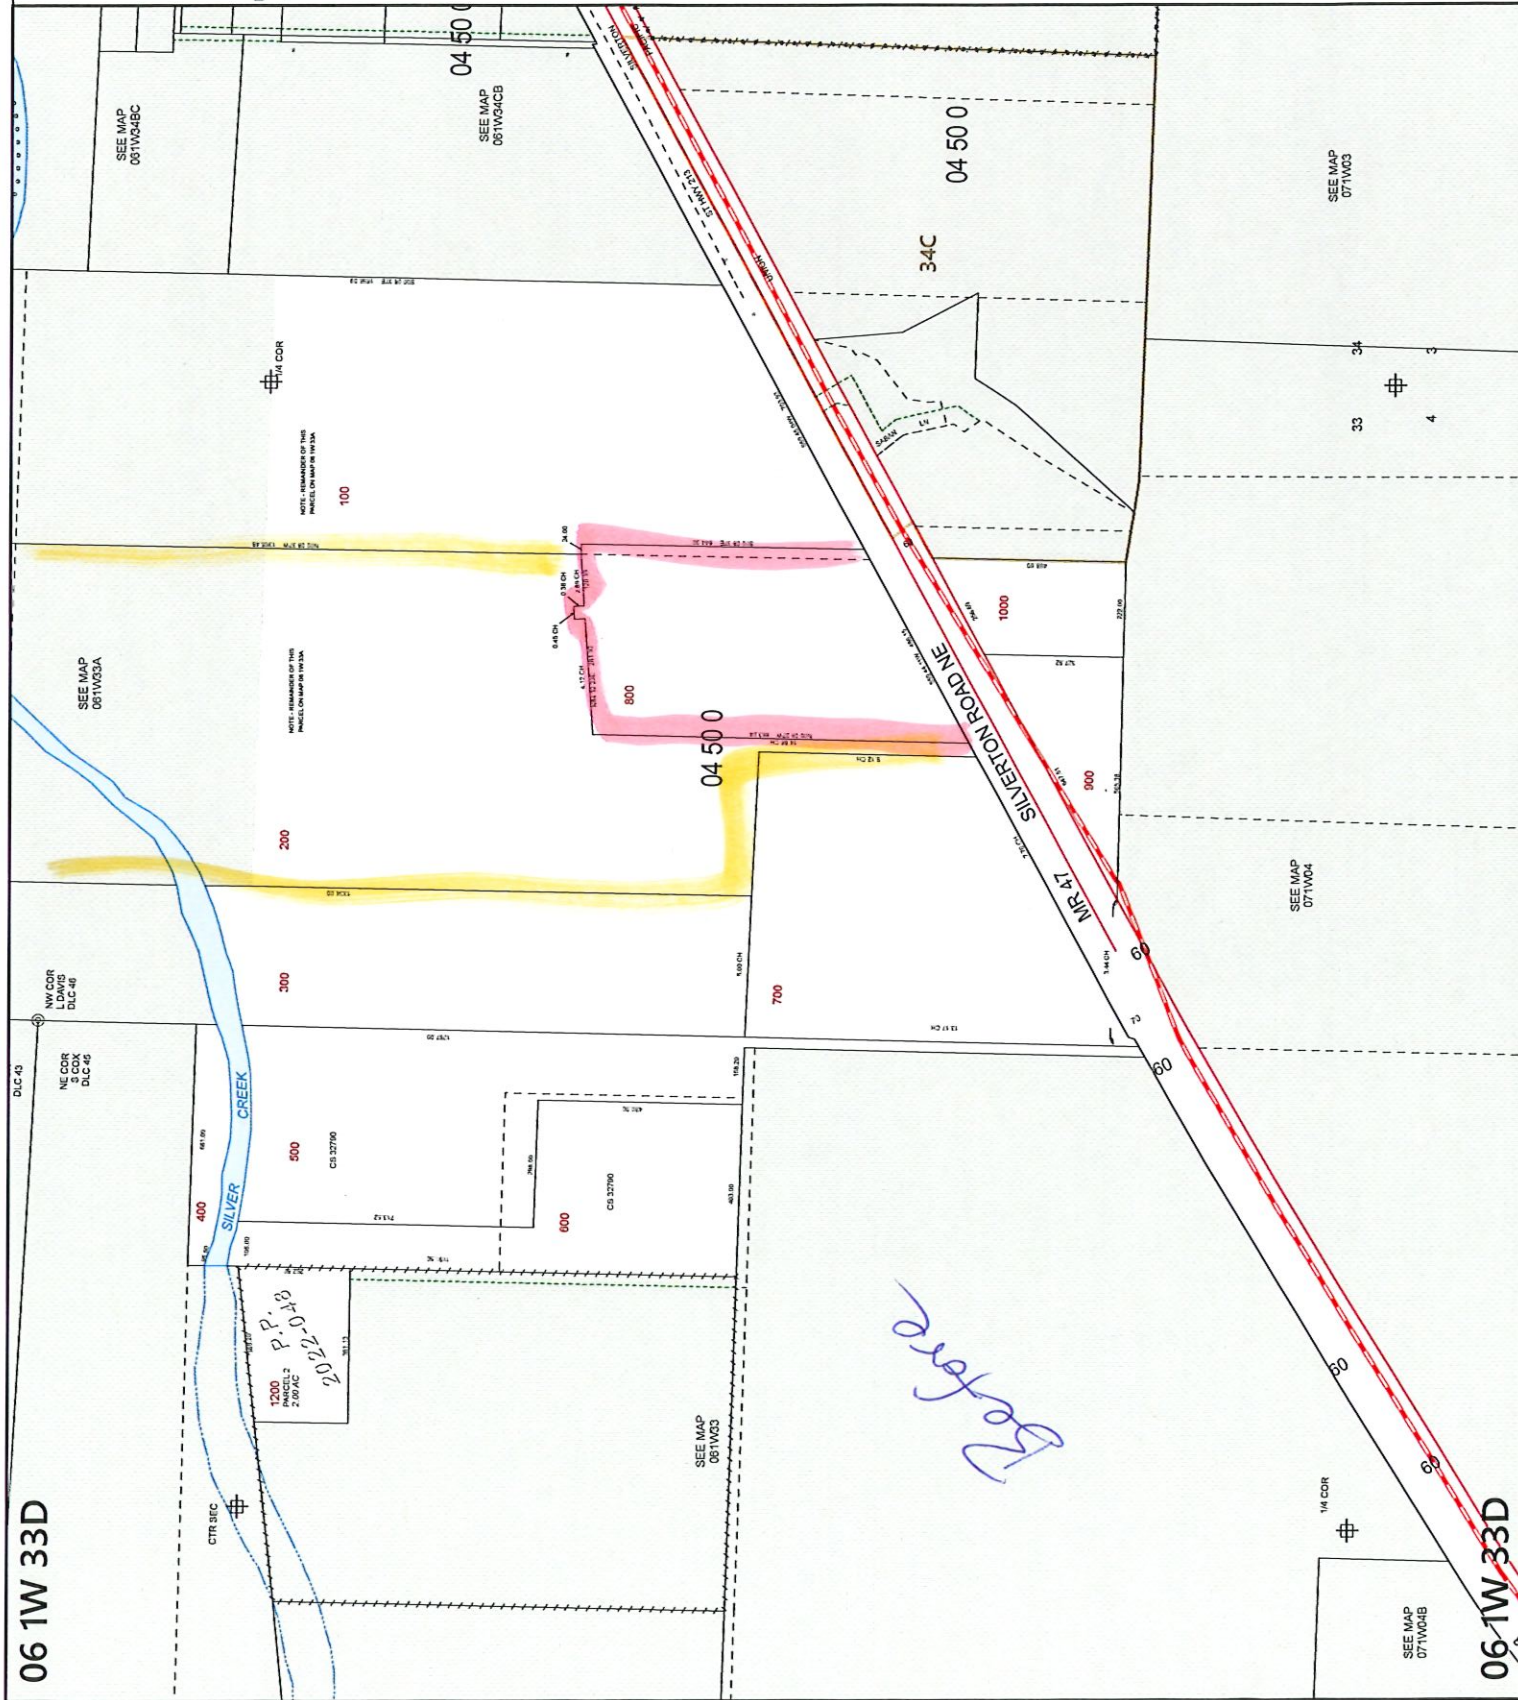

06 1W 33D

06 1W 33D

MARION COUNTY, OREGON
SE1/4 SEC33 T6S R1W W.M.
SCALE 1" = 200'

LEGEND

LINE TYPES

- Taxlot Boundary
- Road Right-of-Way
- Railroad Right-of-Way
- Private Road ROW
- Subdivision/Plat Boundary
- Waterline - Taxlot Boundary
- Waterline - Non Boundary

- Historical Boundary
- Easement
- Railroad Centerline
- Taxcode Line
- Map Boundary
- Waterline - Non Boundary

CORNER TYPES

- + 1/4 Section Corner
- ⊙ D/L Corner
- ⊕ 1/4 Section Corner
- ⊕ 1/4 Section Corner
- ⊕ 1/4 Section Corner

NUMBERS

Tax Code Number
00 00 0

All acres listed are Net Acres, excluding any portions of the taxlot within public ROWs.

NOTES

Tick Marks: A tick mark in the road indicates that the labeled dimension extends into the public ROW

CANCELLED NUMBERS

1100

DISCLAIMER: THIS MAP WAS PREPARED FOR ASSESSMENT PURPOSES ONLY



FOR ADDITIONAL MAPS VISIT OUR WEBSITE AT www.marion.or.us

PLOT DATE: 6/28/2023

06 1W 33D

06 1W 33D

