

Rural Work Order Cover Sheet

RAM Transaction #: 783833 Recording Date: _____ Year: 25 - 26

Account Numbers Involved: 359144 521897 2 of 2

(New accounts in **Green**, Cancelled accounts in **Red**)

Sequence #1: ADJUSTMENT FROM 359144 TO 521897 -1.42

Sequence #2: ADJUSTMENT FROM 359144 TO 521897 +1.42

Sequence #3: _____

Sequence #4: _____

Sequence #5: _____

Sequence #6: _____

Check For:						Forms Included:	
	Yes	No		Yes	No		✓
Move Building Permits	☐	☒	Multi-Section	☐	☒	RAM Report	☒
Move Photos	☐	☒	Tagged for 2 nd year Reset	☐	☒	Processing Forms	☒
Update Apex	☐	☒	Exemptions	☐	☒	Before and After Maps	☒
Update Account Notes	☒	☐	Update Tracker	☐	☐	Multi-Section Processing Form	☐
PAT LIAB Updates	☐	☒				Calculation Form(s)	☐

Miscellaneous Notes: Recorded Date 11/5/2024

Forms Completed By: MLH Date: 4/3/25

Appraisal Review: WW BLS Date: 4/8/25

Data Entry: CWO Date: 4/14/25

Tax Year	Account ID	MTL	Transaction	Voucher Sequence	Recorded Date	Operation	Voucher Notes	Code	+/- Size	Size Type
2025	359144	071W060000301	783833	1	11/5/2024 10:10	LOT LINE ADJUSTMENT - FROM	ADJUSTMENT FROM 359144 TO 521897	4500	-1.42	A
2025	521897	071W060000200	783833	2	11/5/2024 10:10	LOT LINE ADJUSTMENT - TO	ADJUSTMENT FROM 359144 TO 521897	4500	1.42	A

2 of 2

Rural Work Order Processing Form

One Page Per Account

Sequence #: 1 of 2 Account Number: 359144 MTL: 071W060000301 RAM Transaction ID: 783833

Type: ☐ COM ☒ LLA ☐ PPT ☐ SEG ☐ SUB ☐ AC ☐ R of W ☐ Vacate ☐ Map Maintenance

Account Details

Ma Sa Nh: 03 06 00 Prop Class: 550 RMV Class: 500 Part of Unit: Yes ☒ or No ☐

Land Fragment

Account From	Code Area	Liab Yr	Land Class	LUC	Value Source	# of Acres	Zone	Land Adjustments
359144	04500	1974	2BD	005	Farm Use- EFU	24.58	REST	GSOIL
359144	04500	1974	2BI	005	Farm Use- EFU	35.23	REST	GSOIL IRR

Acreage Balance

Beginning Acres:

61.23

Ending Acres:

59.81

Net Gained or Lost:

- 1.42

Improvements

Account From	Code Area	Imp ID	Stat Class	Description & Size	Account From	Code Area	Imp ID	Stat Class	Description & Size

Adjustments: _____

Exception

New MAV: _____

☐ Sys Calc

☒ No Change to MAV

Rural Work Order Processing Form

One Page Per Account

Sequence #: 2 of 2 Account Number: 521897 MTL: 071W060000200 RAM Transaction ID: 783833

Type: ☐ COM ☒ LLA ☐ PPT ☐ SEG ☐ SUB ☐ AC ☐ R of W ☐ Vacate ☐ Map Maintenance

Account Details

Ma Sa Nh: 03 06 000 Prop Class: 551 RMV Class: 501 Part of Unit: Yes ☐ or No ☒

Land Fragment

Account From	Code Area	Liab Yr	Land Class	LUC	Value Source	# of Acres	Zone	Land Adjustments
521897	04500	2009	2BI	005	Farm Homesite	1.00	REST	GSOIL
521897	04500	1984	2BI	005	Farm Use-EFU	14.32	REST	GSOIL IRR
521897	04500	1980	4BI	005	Farm Use-EFU	0.80	REST	IRR
521896	04500	1974	2BI	005	Farm Use-EFU	3.71	REST	GSOIL IRR
359144	04500	1974	2BD	005	Farm Use- EFU	1.42	REST	GSOIL

Acreage Balance	Beginning Acres:	19.83	Ending Acres:	21.25	Net Gained or Lost:	+1.42
------------------------	-------------------------	--------------	----------------------	--------------	----------------------------	--------------

Improvements

Account From	Code Area	Imp ID	Stat Class	Description & Size	Account From	Code Area	Imp ID	Stat Class	Description & Size

Adjustments: _____


Exception

New MAV: _____ ☐ Sys Calc ☒ No Change to MAV

07 1W 06

07 1W 06

AFTER

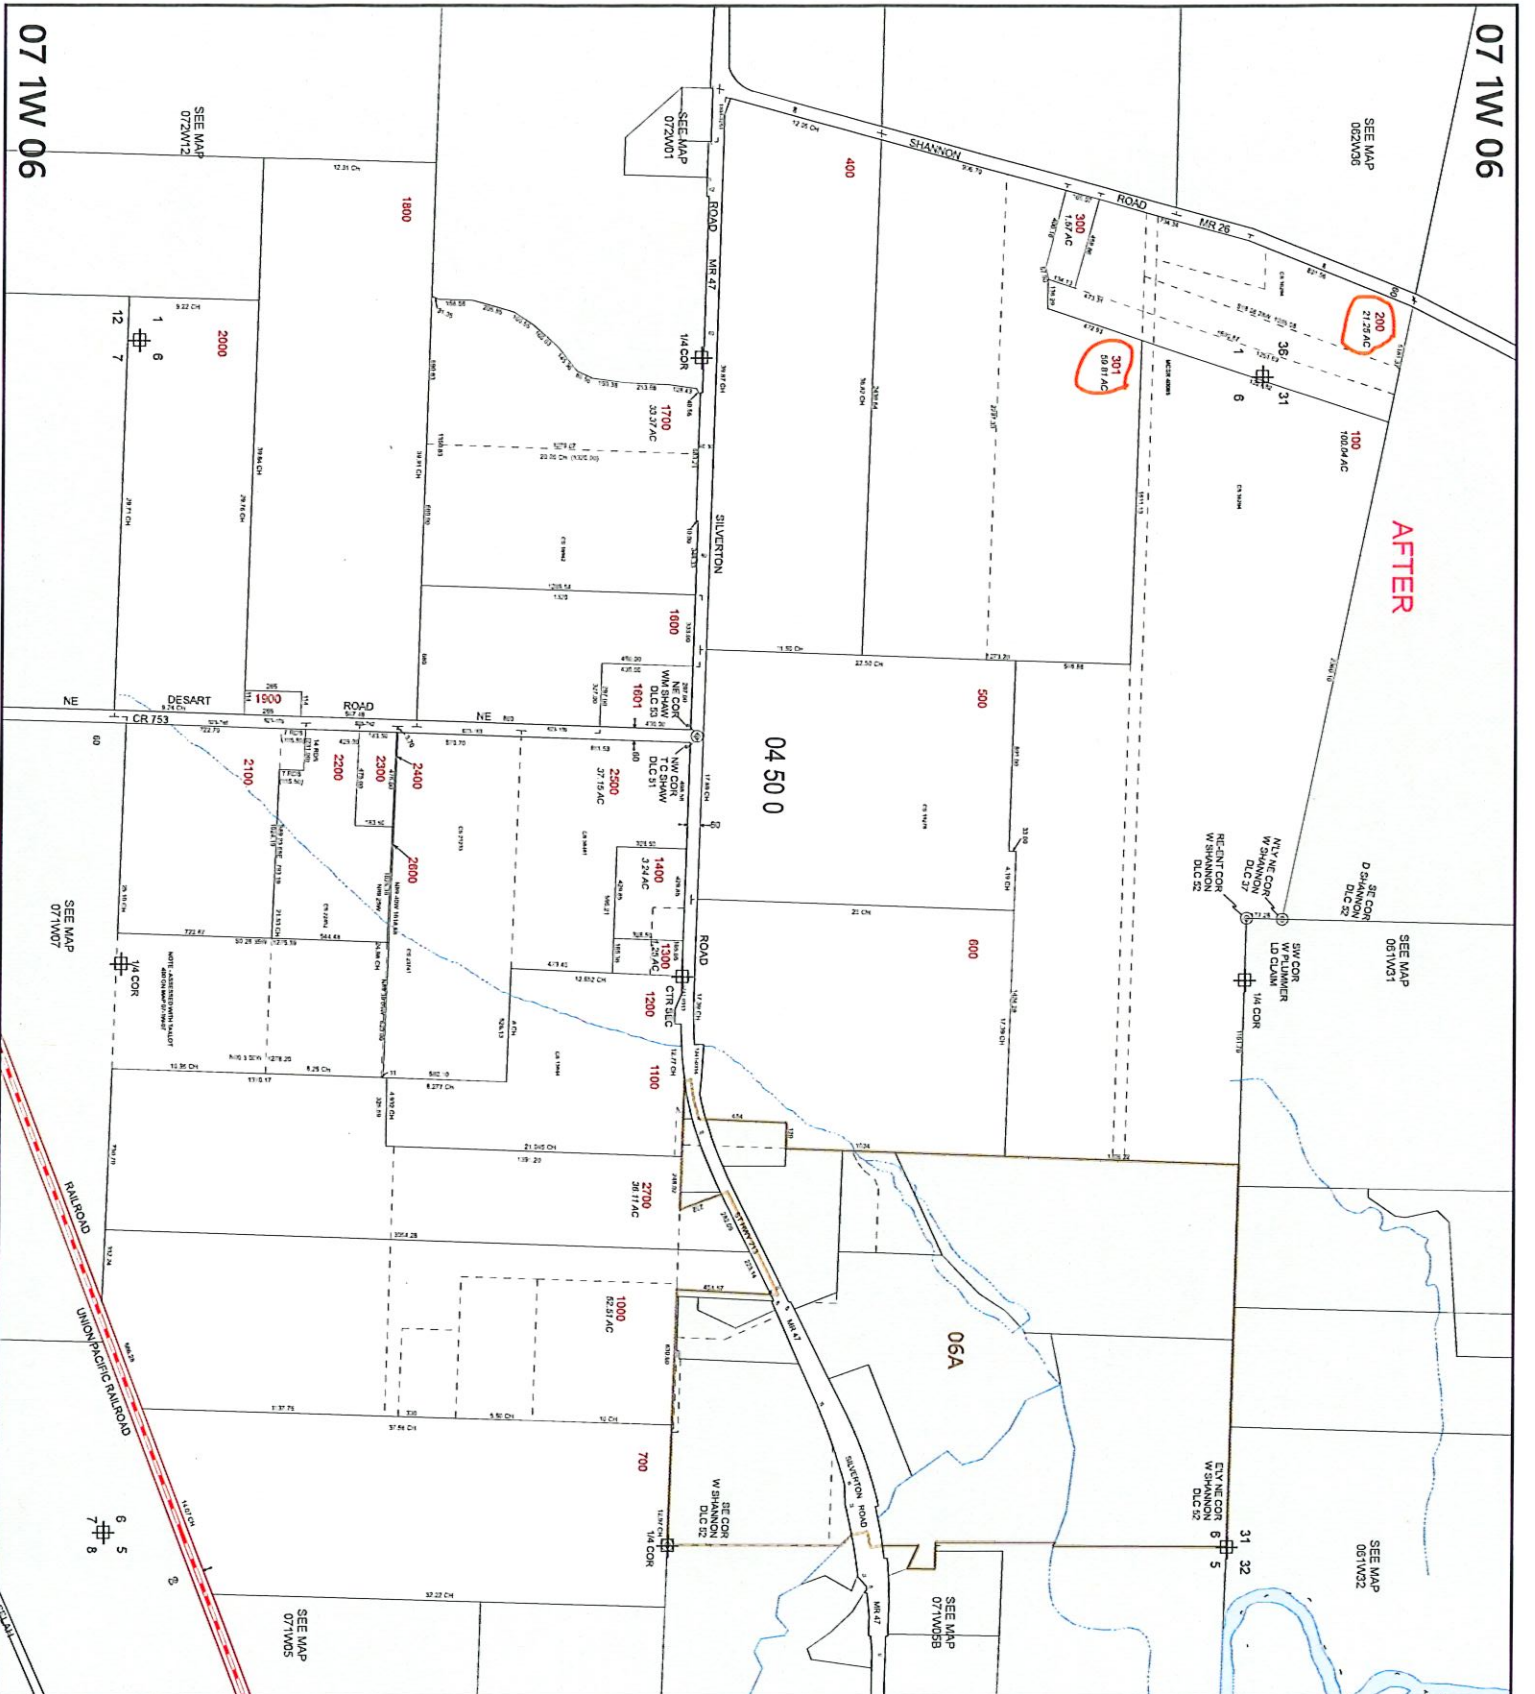

MARION COUNTY, OREGON
SEC 6 T7S R1W W.M.
SCALE 1" = 400'

LINE TYPES

- Taxlot Boundary
- Road Right-of-Way
- Railroad Right-of-Way
- Private Road ROW
- Subdivision/Plat Bndry
- Waterline - Tabled Bndry
- Waterline - Non Bndry
- Historical Boundary
- Eastment
- Railroad Centerline
- Taxlot Line
- Map Boundary
- Waterline - Non Bndry

CORNER TYPES

- + 1/8th Section Cor
- ⊙ D/C Corner
- ⊕ 1/4 Section Cor
- ⊕ 1/8th Section Cor
- ⊕ 1/4 Section Corner
- 21 22

NUMBERS

00 00 0

All acres listed are Net Acres, excluding any 0.25 AC portions of the taxlot within public ROWs.

NOTES

Tick Marks: A tick mark in the road indicates that the labeled dimension extends into the public ROW.

CANCELLED NUMBERS

800
900
1000
1100
1200

DISCLAIMER: THIS MAP WAS PREPARED FOR ASSESSMENT PURPOSES ONLY



FOR ADDITIONAL MAPS VISIT OUR WEBSITE AT WWW.CO.MARION.OREGON

PLOT DATE: 3/27/2025

07 1W 06

07 1W 06