

Rural Work Order Cover Sheet

RAM Transaction #: 785271 Recording Date: _____ Year: 25 - 26

Account Numbers Involved: 328775, 611646

(New accounts in Green, Cancelled accounts in Red)

Sequence #1: PPT PER MARION COUNTY CASE 23-026 611646 SEGREGATED OUT OF 328775 - 1.39

Sequence #2: PPT PER MARION COUNTY CASE 23-026 611646 SEGREGATED OUT OF 328775 + 1.39

Sequence #3: _____

Sequence #4: _____

Sequence #5: _____

Sequence #6: _____

Check For:			Forms Included:		
Yes	No		Yes	No	✓
☐	☒	Move Building Permits	☐	☒	RAM Report ☒
☐	☒	Move Photos	☐	☒	Processing Forms ☒
☒	☒	Update Apex	☐	☒	Before and After Maps ☒
☒	☐	Update Account Notes	☒	☐	Multi-Section Processing Form ☐
☐	☐	PAT LIAB Updates	☐	☐	Calculation Form(s) ☐
		Multi-Section	☐	☒	
		Tagged for 2 nd year Reset	☐	☒	
		Exemptions	☐	☒	
		Update Tracker	☒	☐	

Miscellaneous Notes: RECORDED 11/19/24 RESET 25-26

WW – FOLLOWUP WORKFLOW INVENTORY CORR 328775

Forms Completed By: WW Date: 3/27/25

Appraisal Review: WW BES Date: 3/27/25

Data Entry: CWO Date: 4/17/25

Tax Year	Account ID	MTL	Transaction	Voucher Sequence	Recorded Date	Operation	Voucher Notes	Code	+/- Size	Size Type
2025	328775	082W02A000801	785271	1	11/19/2024 11:41	PARTITION PLAT - FROM	PARTITION PLAT PER MARION COUNTY PLANNING CASE 23- 026. 611646 SEGREGATED OUT OF 328775	92410	-1.39	A
2025	611646	082W02A000803	785271	2	11/19/2024 11:41	PARTITION PLAT - TO	PARTITION PLAT PER MARION COUNTY PLANNING CASE 23- 026. 611646 SEGREGATED OUT OF 328775	92410	1.39	A

One Page Per Account

Type: ☐ COM ☐ LLA ☒ PPT ☐ SEG ☐ SUB ☐ AC ☐ R of W ☐ Vacate ☐ Map Maintenance

Revised 3/27/2025

Rural Work Order Processing Form

One Page Per Account

Sequence #: 2 of 2 Account Number: 611646 MTL: 082W02A000803 RAM Transaction ID: 785271

Type: ☐ COM ☐ LLA ☒ PPT ☐ SEG ☐ SUB ☐ AC ☐ R of W ☐ Vacate ☐ Map Maintenance

Account Details

Ma Sa Nh: 01 06 00 Prop Class: 400 RMV Class: 400 Part of Unit: Yes ☐ or No ☒

Land Fragment

Account From	Code Area	Liab Yr	Land Class	LUC	Value Source	# of Acres	Zone	Land Adjustments
328775	92410		4HI	004	RURAL AT MARKET	1.39	NREST	IRR

Acreage Balance	Beginning Acres:	0	Ending Acres:	1.39	Net Gained or Lost:	+ 1.39
-----------------	------------------	---	---------------	------	---------------------	--------

Improvements

Account From	Code Area	Imp ID	Stat Class	Description & Size	Account From	Code Area	Imp ID	Stat Class	Description & Size


Adjustments:

Exception

New MAV: RESET/EXCEPTION ☒ Sys Calc ☐ No Change to MAV

08 2W 02A

08 2W 02A

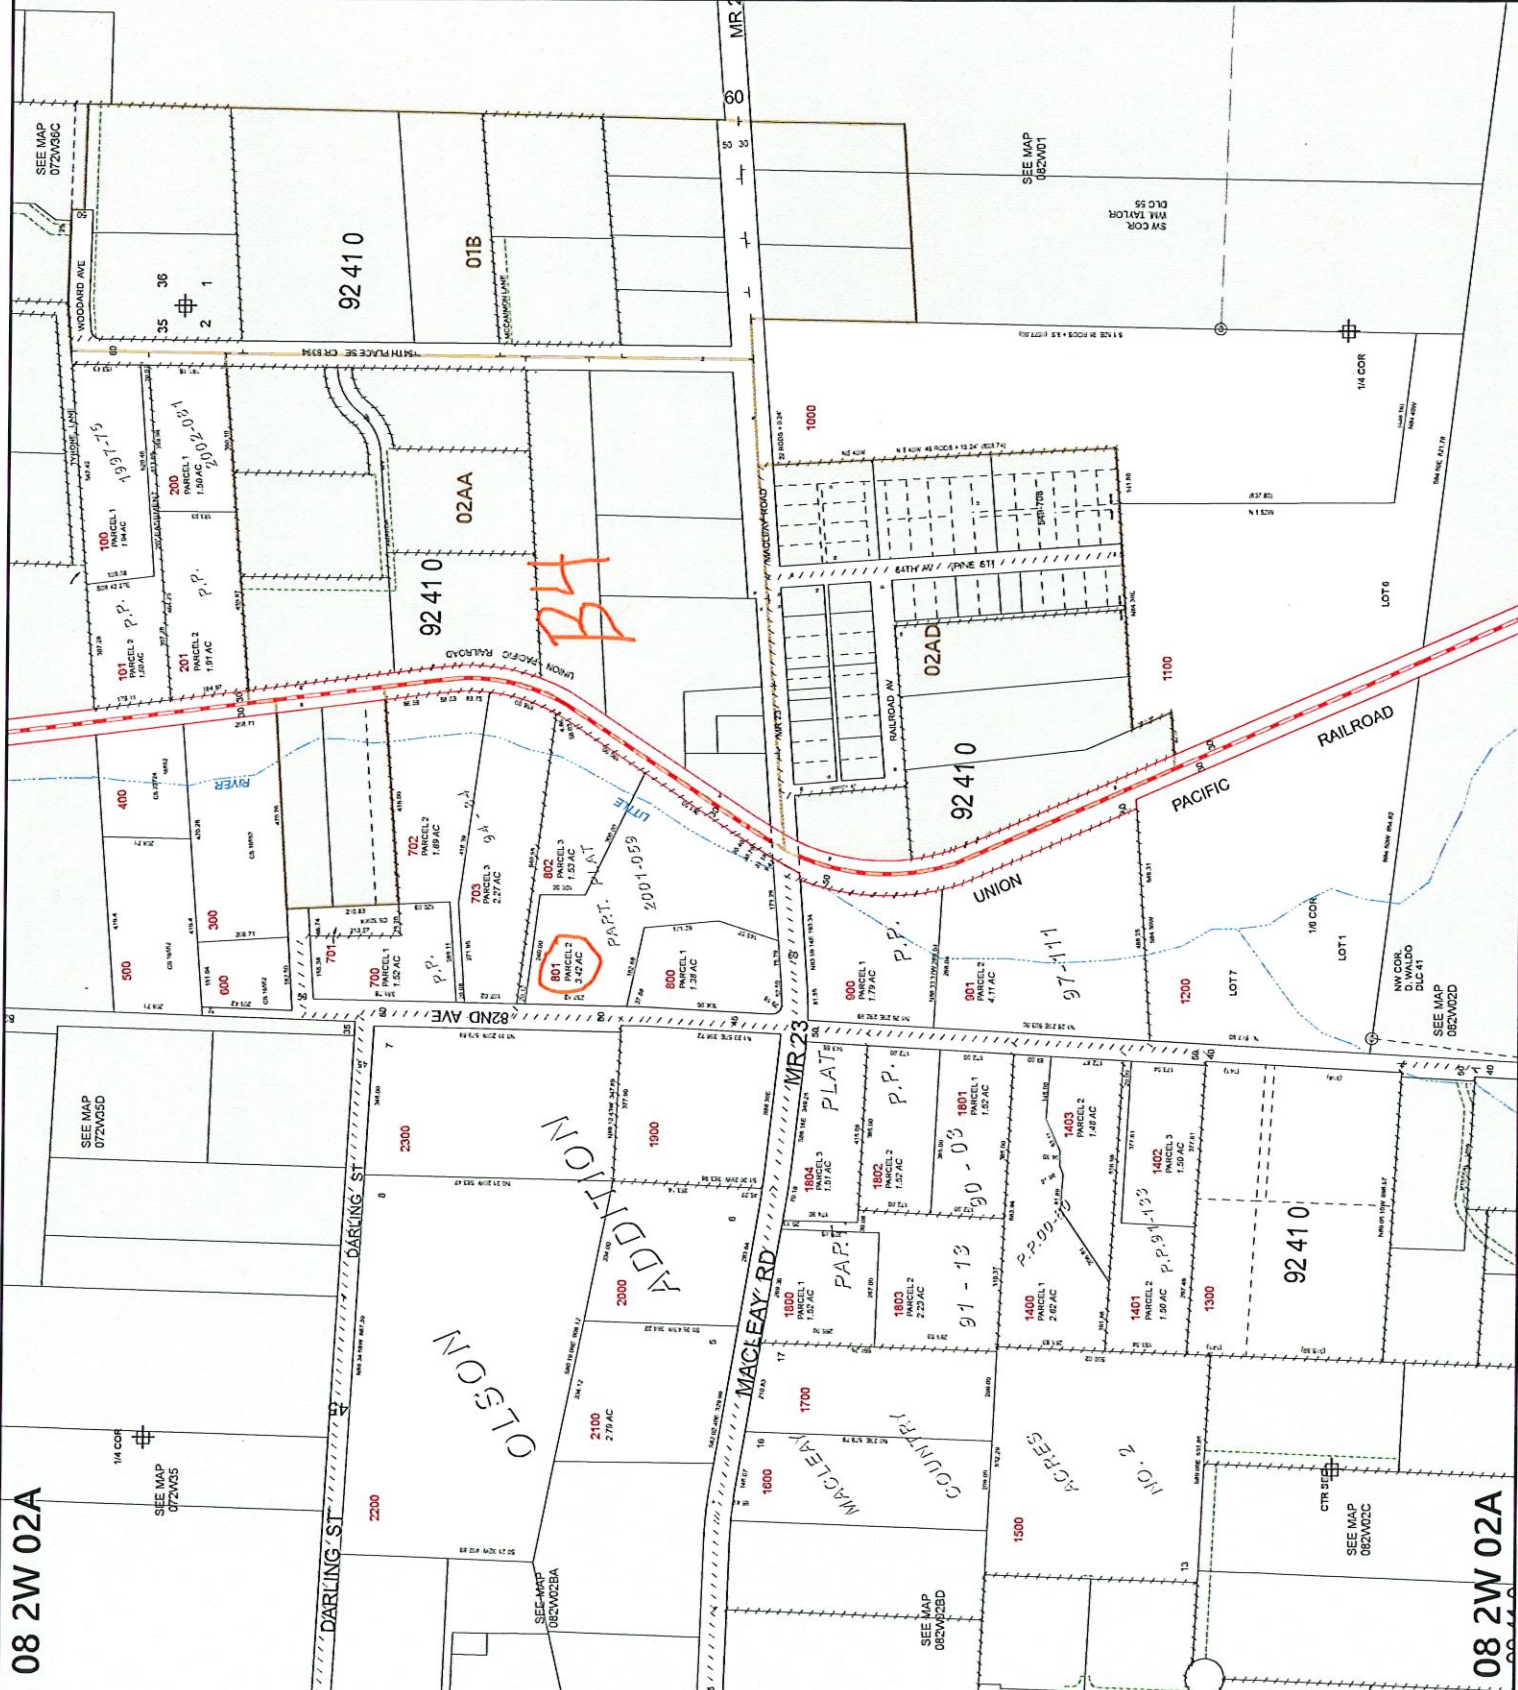

MARION COUNTY, OREGON
NE1/4 SEC2 T8S R2W W.M.
SCALE 1" = 200'

LEGEND

- LINE TYPES**
- Historical Boundary
 - Exeminent
 - Road Right-of-Way
 - Railroad Right-of-Way
 - Private Road ROW
 - Subdivision/Plat Boundary
 - Waterline - Toilet Bndry
 - Waterline - Non Bndry
- CORNER TYPES**
- + 1/16TH Section Cor
 - ⊕ 1/4 Section Cor
 - ⊙ D/C Corner
 - ⊕ 15' 15" Section Corner
 - ⊕ 21' 22"
- NUMBERS**
- Tax Cook Number
00 00 0
- Acres: All acres listed are Net Acres, excluding any portions of the taxlot within public ROWs
- NOTES**
- Tick Marks: A tick mark in the road indicates that the labeled dimension extends into the public ROW

CANCELLED NUMBERS

DISCLAIMER: THIS MAP WAS PREPARED FOR ASSESSMENT PURPOSES ONLY



FOR ADDITIONAL MAPS VISIT OUR WEBSITE AT www.co.marion.or.us

PLOT DATE: 10/16/2020

08 2W 02A

08 2W 02A

08 2W 02A

08 2W 02A

08 2W 02A

08 2W 02A



MARION COUNTY, OREGON
NE1/4 SEC2 T8S R2W W.M.
SCALE 1" = 200'

LEGEND

- LINE TYPES**
- Twist Boundary
 - Road Right-of-Way
 - Railroad Right-of-Way
 - Private Road ROW
 - Subdivision Plat Boundary
 - Waterline - Twist Boundary
 - Waterline - Non Twist
- CORNER TYPES**
- + 1/16th Section Cor
 - ⊕ 1/4 Section Cor
 - ⊙ D/L Corner
 - ⊕ 16' 15" Section Corner
 - ⊕ 21' 22" Section Corner
- NUMBERS**
- Tax Code Number
00 00 0
- All acres listed are Net Acres, excluding any portions of the twist within public ROWs.
- NOTES**
- Tick Marks: A tick mark in the road indicates that the labeled dimension extends into the public ROW

CANCELLED NUMBERS

DISCLAIMER: THIS MAP WAS PREPARED FOR ASSESSMENT PURPOSES ONLY



FOR ADDITIONAL MAPS VISIT OUR WEBSITE AT www.co.marion.or.us

PLOT DATE: 3/24/2025

08 2W 02A

08 2W 02A

08 2W 02A

