

Rural Work Order Cover Sheet

RAM Transaction #: 795685 Recording Date: 1/31/25 Year: 25 - 26

Account Numbers Involved: 519555, 519562 **1 of 3**

(New accounts in **Green**, Cancelled accounts in **Red**)

Sequence #1: ADJUSTMENT FROM 519555 TO 519562 - 0.08 code 1410, -0.31 code 92410

ADJUSTMENT FROM 519555 TO 519562 +0.08. code 1410 +0.31 code 92410

Sequence #2: _____

Sequence #3: _____

Sequence #4: _____

Sequence #5: _____

Sequence #6: _____

Check For:					Forms Included:	
	Yes	No		Yes	No	
Move Building Permits	☐	☒	Multi-Section	☐	☒	RAM Report
Move Photos	☐	☒	Tagged for 2 nd year Reset	☐	☒	Processing Forms
Update Apex	☐	☒	Exemptions	☐	☒	Before and After Maps
Update Account Notes	☒	☐	Update Tracker	☒	☐	Multi-Section Processing Form
PAT LIAB Updates	☐	☒				Calculation Form(s)

Miscellaneous Notes: _____

Forms Completed By: GRH Date: 04.29.25

Appraisal Review: WW **BES** Date: 5/6/25

Data Entry: CWO Date: 6/11/25

Tax Year	Account ID	MTL	Transaction	Voucher Sequence	Recorded Date	Operation	Voucher Notes	Code	+/- Size	Type
2025	519555	063W140000500	795685	1	1/31/2025 14:02	LOT LINE ADJUSTMENT - FROM	ADJUSTMENT FROM 519555 TO 519562	1410	-0.08	A
2025	519555	063W140000500	795685	1	1/31/2025 14:02	LOT LINE ADJUSTMENT - FROM	ADJUSTMENT FROM 519555 TO 519562	92410	-0.31	A
2025	519562	063W140000400	795685	2	1/31/2025 14:02	LOT LINE ADJUSTMENT - TO	ADJUSTMENT FROM 519555 TO 519562	1410	0.08	A
2025	519562	063W140000400	795685	2	1/31/2025 14:02	LOT LINE ADJUSTMENT - TO	ADJUSTMENT FROM 519555 TO 519562	92410	0.31	A

1 of 3

Rural Work Order Processing Form

One Page Per Account

Sequence #: 1 of 2 Account Number: 519555 MTL: 063W140000500 RAM Transaction ID: 795685

Type: ☐ COM ☒ LLA ☐ PPT ☐ SEG ☐ SUB ☐ AC ☐ R of W ☐ Vacate ☐ Map Maintenance

Account Details

Ma Sa Nh: 04 06 000 Prop Class: 551 RMV Class: 501 Part of Unit: Yes ☐ or No ☒

Land Fragment

Account From	Code Area	Liab Yr	Land Class	LUC	Value Source	# of Acres	Zone	Land Adjustments
519555	01410	1976	2BI	005	FARM USE -EFU	6.66	REST	G SOIL, IRR
519555	01410	1980	WST	005	WASTE RURAL	1.60	REST	WASTE
519555	01410	1980	WST	005	WATER	0.40	REST	WASTE
519555	92410	2009	2BD	005	FARM HOMESITE	1.0	REST	GSOIL
519555	92410	2019	2BI	005	FARM USE- EFU	1.0	REST	G SOIL, IRR
519555	92410	1976	2BI	005	FARM USE- EFU	54.25	REST	G SOIL, IRR
519555	92410	1976	4BI	005	FARM USE- EFU	1.10	REST	IRR
519555	92410	1976	4BI	005	FARM USE- EFU	7.90	REST	IRR
519555	92410	1980	WST	005	WASTE RURAL	3.40	REST	WASTE
519555	92410	1976	WST	005	WATER	1.90	REST	WASTE
519555					SA OSD FAIR			

Acreage Balance	Beginning Acres:	79.60	Ending Acres:	79.21	Net Gained or Lost:	-.39
-----------------	------------------	-------	---------------	-------	---------------------	------

Improvements

Account From	Code Area	Imp ID	Stat Class	Description & Size	Account From	Code Area	Imp ID	Stat Class	Description & Size
				NO CHANGES					

Adjustments: _____

Exception

New MAV: _____ ☐ Sys Calc ☒ No Change to MAV

Rural Work Order Processing Form

One Page Per Account

Sequence #: 2 of 2 Account Number: 519562 MTL: 063W140000400 RAM Transaction ID: 795685

Type: ☐ COM ☒ LLA ☐ PPT ☐ SEG ☐ SUB ☐ AC ☐ R of W ☐ Vacate ☐ Map Maintenance

Account Details

Ma Sa Nh: 0406000 Prop Class: 551 RMV Class: 501 Part of Unit: Yes ☒ or No ☐

Land Fragment

Account From	Code Area	Liab Yr	Land Class	LUC	Value Source	# of Acres	Zone	Land Adjustments
519562	01410	2009	2BI	005	Farm Homesite	1.00	REST	G SOIL IRR
519562	01410	1976	2BI	005	Farm Use - EFU	39.00	REST	G SOIL IRR
519562	01410	1980	4BI	005	Farm Use - EFU	2.00	REST	IRR
519562	92410	1976	2BI	005	Farm Use - EFU	21.00	REST	G SOIL IRR
519562	92410	1980	4BI	005	Farm Use - EFU	0.89	REST	IRR
519555	01410	1976	2BI	005	FARM USE -EFU	0.08	REST	G SOIL, IRR
519555	92410	1976	2BI	005	FARM USE- EFU	0.31	REST	G SOIL, IRR
519555					SA OSD AVG			

Acreage Balance	Beginning Acres:	63.89	Ending Acres:	64.28	Net Gained or Lost:	+.39
-----------------	------------------	-------	---------------	-------	---------------------	------

Improvements

Account From	Code Area	Imp ID	Stat Class	Description & Size	Account From	Code Area	Imp ID	Stat Class	Description & Size
				NO CHANGES					

Adjustments: _____

Exception


New MAV: _____ ☐ Sys Calc ☒ No Change to MAV

06 3W 14

06 3W 14

06 3W 14

06 3W 14

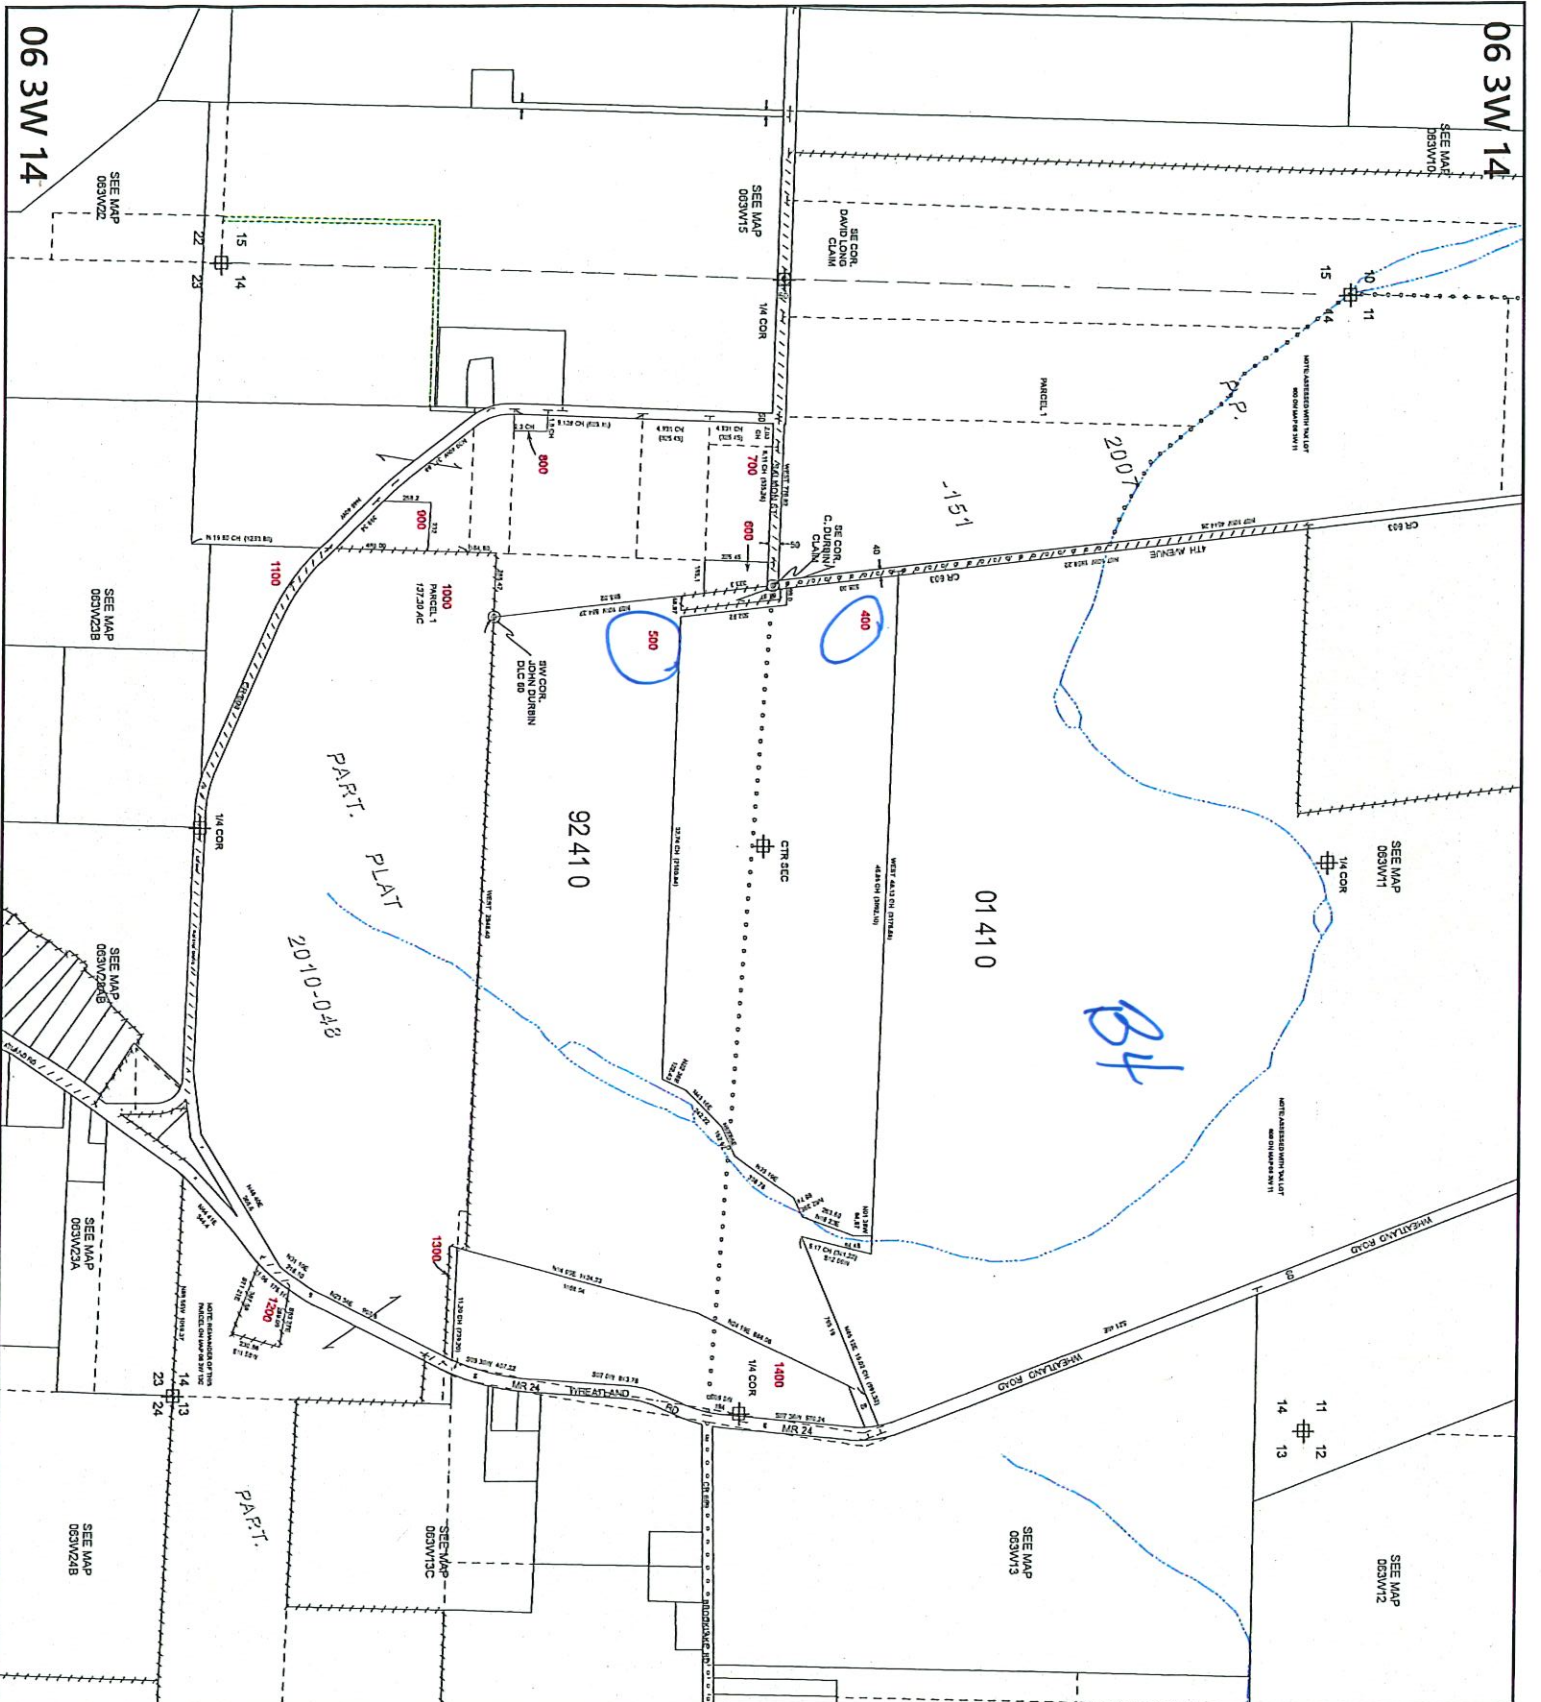

MARION COUNTY, OREGON
SEC 14 T6S R3W W.M.
SCALE 1" = 400'

LEGEND

- LINE TYPES**
- Tablot Boundary
 - Road Right-of-Way
 - Railroad Right-of-Way
 - Private Road ROW
 - Subdivision Plat Boundary
 - Waterline - Tank Bndry
 - Waterline - Non Bndry
 - Historical Boundary
 - Easement
 - Railroad Centerline
 - Taxcode Line
 - Map Boundary

CORNER TYPES

- + 1/6TH Section Cor.
- ⊙ D.C. Corner
- ⊕ 1/4 Section Cor.
- ⊕ 16, 15 Section Corner
- ⊕ 21, 22

NUMBERS

- Tax Code Number
- 00 00 0

NOTES

All acres listed are Net Acres, excluding any 0.25 AC portions of the tablot within public ROWs.



CANCELLED NUMBERS

300

DISCLAIMER: THIS MAP WAS PREPARED FOR ASSESSMENT PURPOSES ONLY



FOR ADDITIONAL MAPS VISIT OUR WEBSITE AT
WWW.CO.MARION.ORG

PLOT DATE: 10/16/2020

06 3W 14

SEE MAP
083W10

SEE MAP
083W11

SEE MAP
083W12

06 3W 14



MARION COUNTY, OREGON
SEC 14 T6S R3W W.M.
SCALE 1" = 400'

LEGEND

- LINE TYPES**
- Taxlot Boundary
 - Road Right-of-Way
 - Railroad Right-of-Way
 - Private Road ROW
 - Subdivision/Plot Boundary
 - Waterline - Taxlot Boundary
 - Waterline - Non Boundary
 - Historical Boundary
 - Easement
 - Railroad Centerline
 - Taxcode Line
 - Map Boundary

CORNER TYPES

- + 1/8th Section Cor
- ⊙ D/C Corner
- ⊕ 1/4 Section Cor
- ⊕ 1/4 Section Corner
- ⊕ 21 22

NUMBERS

- Tax Code Number
- 00 00 0

NOTES

Tick Mark: A tick mark in the road indicates that the labeled dimension extends into the public ROW



CANCELLED NUMBERS

300

DISCLAIMER: THIS MAP WAS PREPARED FOR ASSESSMENT PURPOSES ONLY



FOR ADDITIONAL MAPS VISIT OUR WEBSITE AT
WWW.CO.MARION.ORG

PLOT DATE: 4/16/2025

06 3W 14

SEE MAP
083W22

SEE MAP
083W28

SEE MAP
083W24B

SEE MAP
083W23A

SEE MAP
083W24B

06 3W 14