

Rural Work Order Cover Sheet

RAM Transaction #: 799237 Recording Date: 4/1/25 Year: 25 - 26

Account Numbers Involved: 542073 612035

(New accounts in **Green**, Cancelled accounts in **Red**)

Sequence #1: SIZE CORRECTION -0.25 542073

Sequence #2: PARTITION PLAT PER MARION COUNTY CASE NO CU/P 24-008. 612035 SEGREGATED OUT OF 542073
-4.25 542073

Sequence #3: PARTITION PLAT PER MARION COUNTY CASE NO CU/P 24-008. 612035 SEGREGATED OUT OF 542073
+4.25 612035

Sequence #4: _____

Sequence #5: _____

Sequence #6: _____

Check For:					Forms Included:	
	Yes	No		Yes	No	
Move Building Permits	☐	☒	Multi-Section	☐	☒	RAM Report
Move Photos	☐	☒	Tagged for 2 nd year Reset	☒	☐	Processing Forms
Update Apex	☐	☒	Exemptions	☐	☒	Before and After Maps
Update Account Notes	☒	☐	Update Tracker	☒	☐	Multi-Section Processing Form
PAT LIAB Updates	☐	☐				Calculation Form(s)

Miscellaneous Notes:

(Follow up workflow to correct soil, inventory, etc?)

DFL

Forms Completed By: WW

Date: 5/20/25

Appraisal Review: WW

Date: 5/20/25

Data Entry: CWO

Date: 5/22/25

Tax Year	Account ID	MTL	Transaction	Voucher Sequence	Recorded Date	Operation	Voucher Notes	Code	+/- Size	Size Type
2025	542073	094E300000400	799237	1	4/1/2025 9:19	SIZE CHANGE	SIZE CORRECTION	56490	-0.25	A
2025	542073	094E300000400	799237	2	4/1/2025 9:19	PARTITION PLAT - FROM	PARTITION PLAT PER MARION COUNTY CASE NO CU/P 24- 008. 612035 SEGREGATED OUT OF 542073	56490	-4.25	A
2025	612035	094E300000401	799237	3	4/1/2025 9:19	PARTITION PLAT - TO	PARTITION PLAT PER MARION COUNTY CASE NO CU/P 24- 008. 612035 SEGREGATED OUT OF 542073	56490	4.25	A

Rural Work Order Processing Form

One Page Per Account

Sequence #: 1 of 3 Account Number: 542073 MTL: 094E300000400 RAM Transaction ID: 799237

Type: ☐ COM ☐ LLA ☐ PPT ☐ SEG ☐ SUB ☒ AC ☐ R of W ☐ Vacate ☐ Map Maintenance

Account Details

Ma Sa Nh: 01 06 000 Prop Class: 640 RMV Class: 400 Part of Unit: Yes ☒ or No ☐

Land Fragment

Account From	Code Area	Liab Yr	Land Class	LUC	Value Source	# of Acres	Zone	Land Adjustments
542073	56490	1978	FTLC	005	DESIGNATED FOREST L	82.00	REST	TCCVT
542073	56490	2008	FTLD	005	DESIGNATED FOREST L	0.51	REST	TCCVT
542073	56490	1978	FTLD	005	DESIGNATED FOREST L	33.74	REST	TCCVT

Acreage Balance	Beginning Acres:	116.50	Ending Acres:	116.25	Net Gained or Lost:	-0.25
-----------------	------------------	--------	---------------	--------	---------------------	-------

Improvements

Account From	Code Area	Imp ID	Stat Class	Description & Size	Account From	Code Area	Imp ID	Stat Class	Description & Size

Adjustments: _____

Exception

New MAV: _____ ☐ Sys Calc ☒ No Change to MAV

Rural Work Order Processing Form

One Page Per Account

Sequence #: 2 of 3 Account Number: 542073 MTL: 094E300000400 RAM Transaction ID: 799237

Type: ☐ COM ☐ LLA ☒ PPT ☐ SEG ☐ SUB ☐ AC ☐ R of W ☐ Vacate ☐ Map Maintenance

Account Details

Ma Sa Nh: 01 06 000 Prop Class: 640 RMV Class: 400 Part of Unit: Yes ☒ or No ☐

Land Fragment

Account From	Code Area	Liab Yr	Land Class	LUC	Value Source	# of Acres	Zone	Land Adjustments
542073	56490	1978	FTLC	005	DESIGNATED FOREST L	82.00	REST	TCCVT
542073	56490	2008	FTLD	005	DESIGNATED FOREST L	0.51	REST	TCCVT
542073	56490	1978	FTLD	005	DESIGNATED FOREST L	29.49	REST	TCCVT

Acreage Balance	Beginning Acres:	116.25	Ending Acres:	112.0	Net Gained or Lost:	-4.25
-----------------	------------------	--------	---------------	-------	---------------------	-------

Improvements

Account From	Code Area	Imp ID	Stat Class	Description & Size	Account From	Code Area	Imp ID	Stat Class	Description & Size

Adjustments: _____

Exception

New MAV: _____ ☐ Sys Calc ☒ No Change to MAV

Rural Work Order Processing Form

One Page Per Account

Sequence #: 3 of 3 Account Number: 612035 MTL: 094E300000401 RAM Transaction ID: 799237

Type: ☐ COM ☐ LLA ☒ PPT ☐ SEG ☐ SUB ☐ AC ☐ R of W ☐ Vacate ☐ Map Maintenance

Account Details

Ma Sa Nh: 01 06 000 Prop Class: 640 RMV Class: 400 Part of Unit: Yes ☒ or No ☐

Land Fragment

Account From	Code Area	Liab Yr	Land Class	LUC	Value Source	# of Acres	Zone	Land Adjustments
542073	56490	1978	FTLD	005	DESIGNATED FOREST L	4.25	REST	TCCVT

Acreage Balance	Beginning Acres:	0	Ending Acres:	4.25	Net Gained or Lost:	+4.25
-----------------	------------------	---	---------------	------	---------------------	-------

Improvements

Account From	Code Area	Imp ID	Stat Class	Description & Size	Account From	Code Area	Imp ID	Stat Class	Description & Size

Adjustments: _____

Exception

New MAV: _____ ☐ Sys Calc ☒ No Change to MAV

09 4E 30

09 4E 30

SEE MAP
003E24

SEE MAP 004E



MARION COUNTY, OREGON
SEC 30 T9S R4E W.M.
SCALE 1" = 400'

LEGEND

LINE TYPES

- Historical Boundary
- Taxlot Boundary
- Road Right-of-Way
- Railroad Right-of-Way
- Private Road ROW
- Subdivision Plat Boundary
- Waterline - Taxlot Boundary
- Waterline - Non Boundary
- Evenment
- Railroad Centerline
- Taxcode Line
- Map Boundary
- Waterline - Non Boundary

CORNER TYPES

- + 1/16TH Section Cor
- ⊕ 1/4 Section Cor
- ⊙ D/C Corner
- ⊕ 16 1/5 Section Corner
- ⊕ 21 22

NUMBERS

Tax Code Number
00 00 0

All acres listed are Net Acres, excluding any portions of the taxlot within public ROWs

NOTES

Tick Marks: A tick mark in the road indicates that the labeled dimension extends into the public ROW

CANCELLED NUMBERS

DISCLAIMER: THIS MAP WAS PREPARED FOR ASSESSMENT PURPOSES ONLY




FOR ADDITIONAL MAPS VISIT OUR WEBSITE AT www.co.marion.or.us

PLOT DATE: 10/17/2020

09 4E 30

09 4E 30

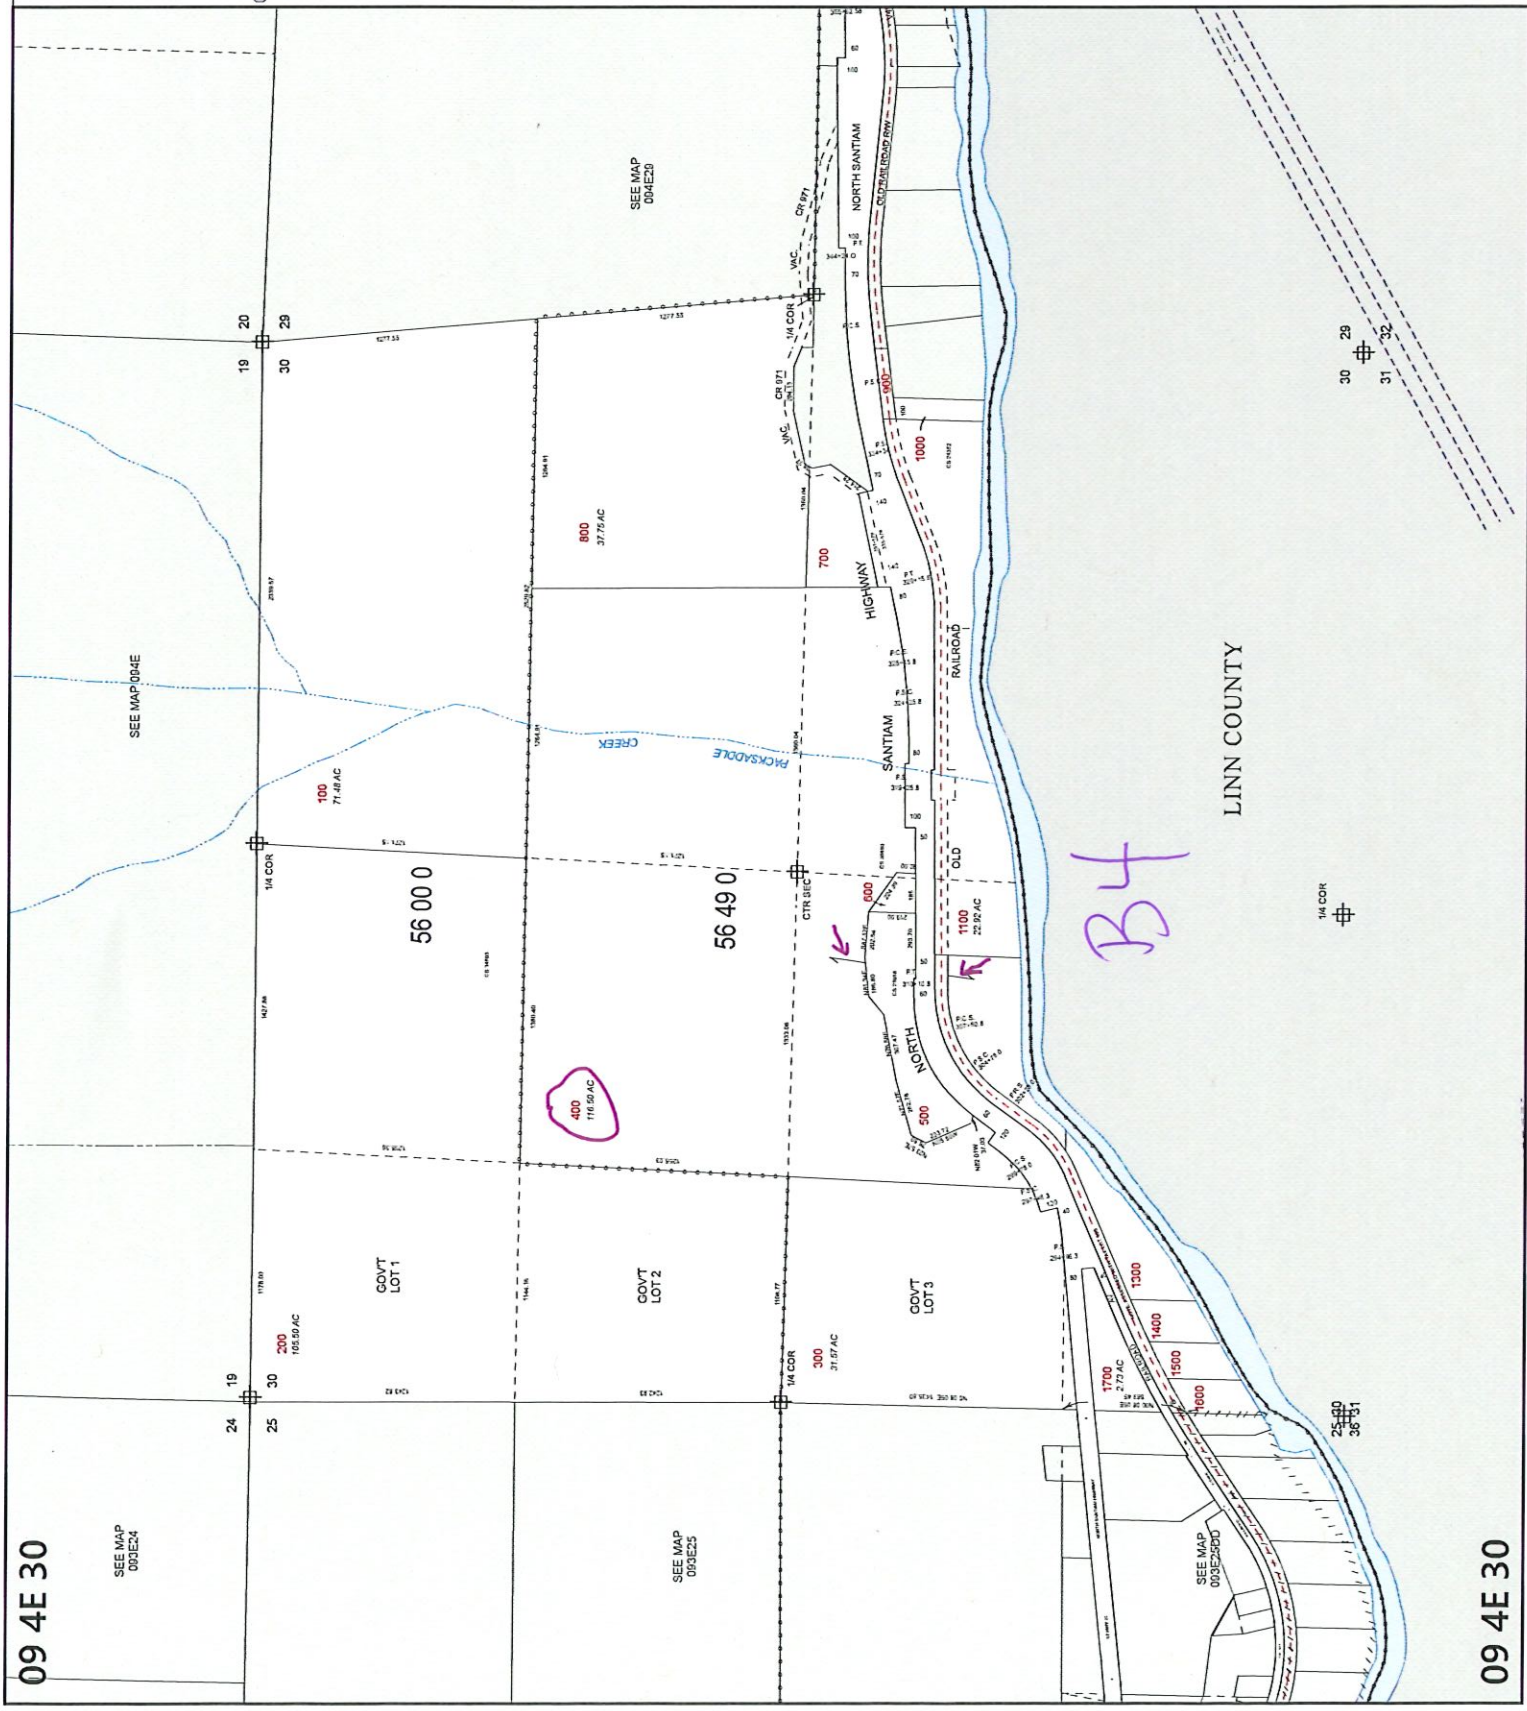

SEE MAP
003E24

MARION COUNTY, OREGON
SEC 30 T9S R4E W.M.

SCALE 1" = 400'

LEGEND

LINE TYPES

Taxlot Boundary
 Road Right-of-Way
 Railroad Right-of-Way
 Private Road ROW
 Subdivision/Plat Bndry
 Waterline - Taxlot Bndry

Historical Boundary
 Easement
 Railroad Centerline
 Taxcode Line
 Map Boundary
 Waterline - Non Bndry

CORNER TYPES

+ 1/16TH Section Cor.
© DLC Corner

NUMBERS

Hex Code Number
00 00 0

Acres All acres listed are Net Acres, excluding any portions of the taxlot within public ROWs

NOTES

Tick Marks: A tick mark in the road indicates that the labeled dimension extends into the public ROW

CANCELLED NUMBERS

DISCLAIMER: THIS MAP WAS PREPARED
FOR ASSESSMENT PURPOSES ONLY



Assessors Office
Cartography Dept

FOR ADDITIONAL MAPS VISIT OUR WEBSITE AT
www.co.marion.or.us

PLOT DATE: 5/7/2025

09 4E 30

09 4E 30