

Rural Work Order Cover Sheet

RAM Transaction #: 799459 Recording Date: 3/13/25 Year: 25 - 26

Account Numbers Involved: 510469

(New accounts in **Green**, Cancelled accounts in **Red**)

Sequence #1: DEDICATION TO COLE LN (-0.06)

Sequence #2: _____

Sequence #3: _____

Sequence #4: _____

Sequence #5: _____

Sequence #6: _____

Check For:			Forms Included:		
	Yes	No		Yes	No
Move Building Permits	☐	☒	Multi-Section	☐	☒
Move Photos	☐	☒	Tagged for 2 nd year Reset	☐	☒
Update Apex	☐	☒	Exemptions	☐	☒
Update Account Notes	☐	☐	Update Tracker	☒	☐
PAT LIAB Updates	☐	☐			
			RAM Report		☒
			Processing Forms		☒
			Before and After Maps		☒
			Multi-Section Processing Form		☐
			Calculation Form(s)		☐

Miscellaneous Notes:

(Follow up workflow to correct soil, inventory, etc?)

Forms Completed By: JJS Date: 5/7/25

Appraisal Review: WW BLS Date: 5/20/25

Data Entry: CWO Date: 5/23/25

Tax Year	Account ID	MTL	Transaction	Voucher Sequence	Recorded Date	Operation	Voucher Notes	Code	+/- Size	Size Type
2025	510469	041W11D000100	799459	1	3/13/2025 10:49	DEDICATION	DEDICATION TO COLE LN	15560	-0.06	A

Rural Work Order Processing Form

One Page Per Account

Sequence #: 1 of 1 Account Number: 510469 MTL: 041W11D000100 RAM Transaction ID: 799459

Type: ☐ COM ☐ LLA ☐ PPT ☐ SEG ☐ SUB ☐ AC ☒ R of W ☐ Vacate ☐ Map Maintenance

Account Details

Ma Sa Nh: 02/06/000 Prop Class: 940 RMV Class: 450 Part of Unit: Yes ☐ or No ☒

Land Fragment

Account From	Code Area	Liab Yr	Land Class	LUC	Value Source	# of Acres	Zone	Land Adjustments
510469	15560	2009	2BD	005	RURAL RESTRICTIVE	1	REST	GSOIL
510469	15560	1992	2BD	005	RURAL RESTRICTIVE	.95	REST	
510469	15560	1992	6H	005	RURAL RESTRICTIVE	1	REST	

Acreage Balance	Beginning Acres:	3.01	Ending Acres:	2.95	Net Gained or Lost:	-0.06
-----------------	------------------	------	---------------	------	---------------------	-------

Improvements

Account From	Code Area	Imp ID	Stat Class	Description & Size	Account From	Code Area	Imp ID	Stat Class	Description & Size
				N/A					


Adjustments: _____

Exception

New MAV: _____ ☐ Sys Calc ☒ No Change to MAV

04 1W 11D

04 1W 11D

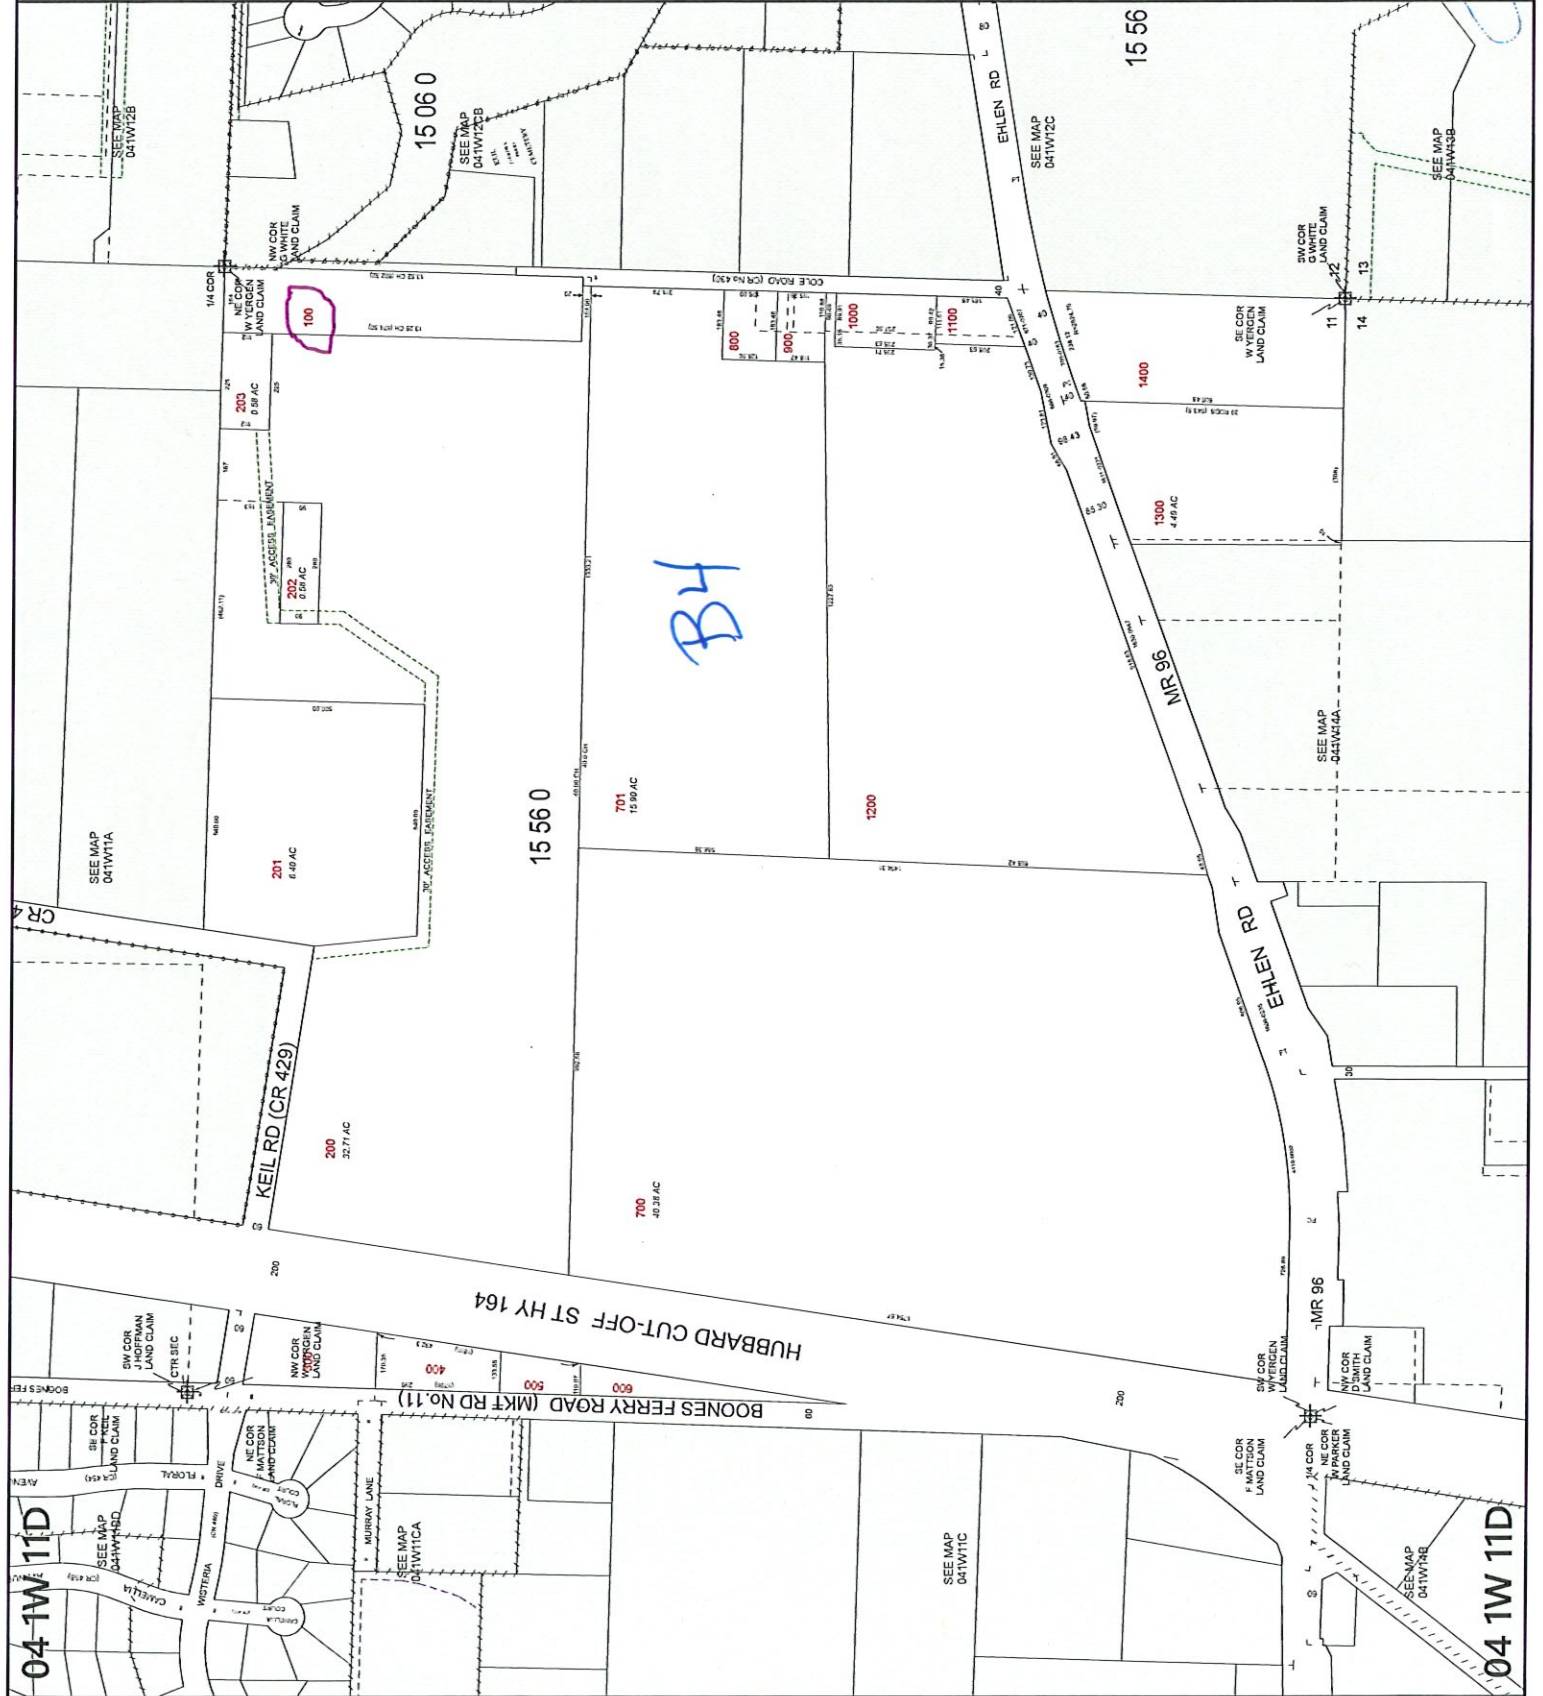

MARION COUNTY, OREGON
SE 1/4 SEC 11 T4S R1W W.M.
SCALE 1" = 200'

LEGEND

- LINE TYPES**
- Historical Boundary
 - Section Boundary
 - Road Right-of-Way
 - Railroad Right-of-Way
 - Private Road
 - Subdivision/Plat Boundary
 - Waterline - Toilet Body
 - Waterline - Non Body
- CORNER TYPES**
- + 1/4 Section Cor
 - ⊕ 1/16th Section Cor
 - ⊙ D/C Corner
 - ⊕ 1/4 Section Cor
 - ⊕ 1/16th Section Cor
 - ⊙ D/C Corner

NUMBERS

Tax Code Number

00 00 0

00 00 0

NOTES

Tick Marks: A tick mark in the road indicates that the labeled dimension extends into the public ROW

CANCELLED NUMBERS	
1101	
1201	
1401	

DISCLAIMER: THIS MAP WAS PREPARED FOR ASSESSMENT PURPOSES ONLY



FOR ADDITIONAL MAPS VISIT OUR WEBSITE AT www.co.marion.or.us

PLOT DATE: 6/28/2023

04 1W 11D

04 1W 11D

04 1W 11D



MARION COUNTY, OREGON
SE1/4 SEC11 T4S R1W W.M.
SCALE 1" = 200'

LEGEND

LINE TYPES

- Taxlot Boundary
- Road Right-of-Way
- Railroad Right-of-Way
- Private Road ROW
- Subdivision Plat Boundary
- Waterline - Toilet Body
- Waterline - Non Body
- Historical Boundary
- Easement
- Railroad Centerline
- Taxcode Line
- Map Boundary

CORNER TYPES

- + 1/16TH Section Cor.
- ⊙ D/C Corner
- ⊕ 1/4 Section Cor.
- ⊕ 16 15 Section Corner
- ⊕ 21 22

NUMBERS

Tax Code Number
00 00 0

All acres listed are Net Acres, excluding any
0.25 AC portions of the taxlot within public ROWs

NOTES

Tick Marks: A tick mark in the road indicates that the
labelled dimension extends into the public ROW

CANCELLED NUMBERS

1101
1201
1401

DISCLAIMER: THIS MAP WAS PREPARED
FOR ASSESSMENT PURPOSES ONLY



FOR ADDITIONAL MAPS VISIT OUR WEBSITE AT
www.co.marion.or.us

PLOT DATE: 4/30/2025

04 1W 11D

