


SKETCH/AREA TABLE ADDENDUM

SUBJECT INFO

File No.: 331673 Parcel No.: 072W08BA12400
 Property Address: 4447 Plow Ct NE/4447 Plow Ct NE Unit A
 City: Salem County: Marion State: OR ZipCode: 97305
 Owner:
 Client: Client Address:
 Appraiser Name: Inspection Date:

SKETCH

331673
072W08BA12400

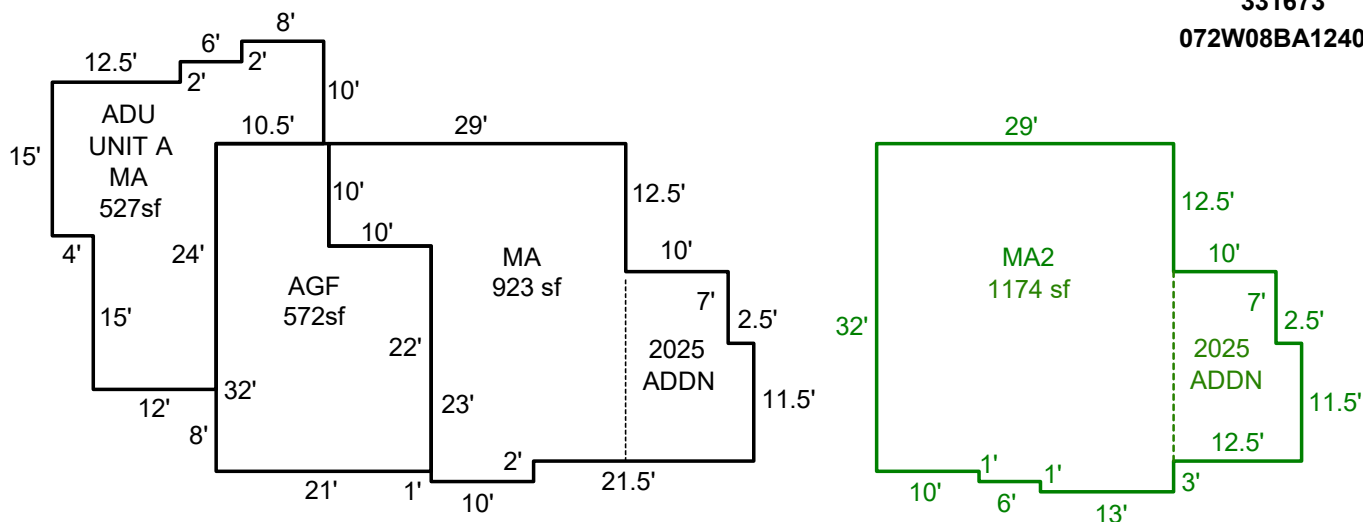

Sketch by ApexSketch

AREA CALCULATIONS SUMMARY

Code	Description	Factor	Net Size	Perimeter	Net Totals
GLA	MA	1.0	922.8	149.0	
	MA	1.0	527.0	121.0	1449.8
GLA2	MA2	1.0	1173.8	151.0	1173.8
GAR	AGF	1.0	572.0	106.0	572.0

COMMENT TABLE 1

Drawn by Pat Long 09/08/2009
 UPDATED BY JT 4/30/24
 Updated by AE 5.28.25
 Updated by AE 1.28.26

COMMENT TABLE 2

3/25/19 #28 N/V
 12-19-24 GM Tag
 1-21-26 KK Tag

COMMENT TABLE 3

Net LIVABLE cnt 3 (rounded) 2,624