

SKETCH/AREA TABLE ADDENDUM


SUBJECT INFO

File No.: 598077 Parcel No.: 105E01BC19100
 Property Address: 125 DETROIT AV N
 City: DETROIT County: State: OR ZipCode: 97342
 Owner:
 Client: Client Address:
 Appraiser Name: Inspection Date:

SKETCH

598077
105E01BC19100

26-27: ALL IMPROVEMENTS GONE

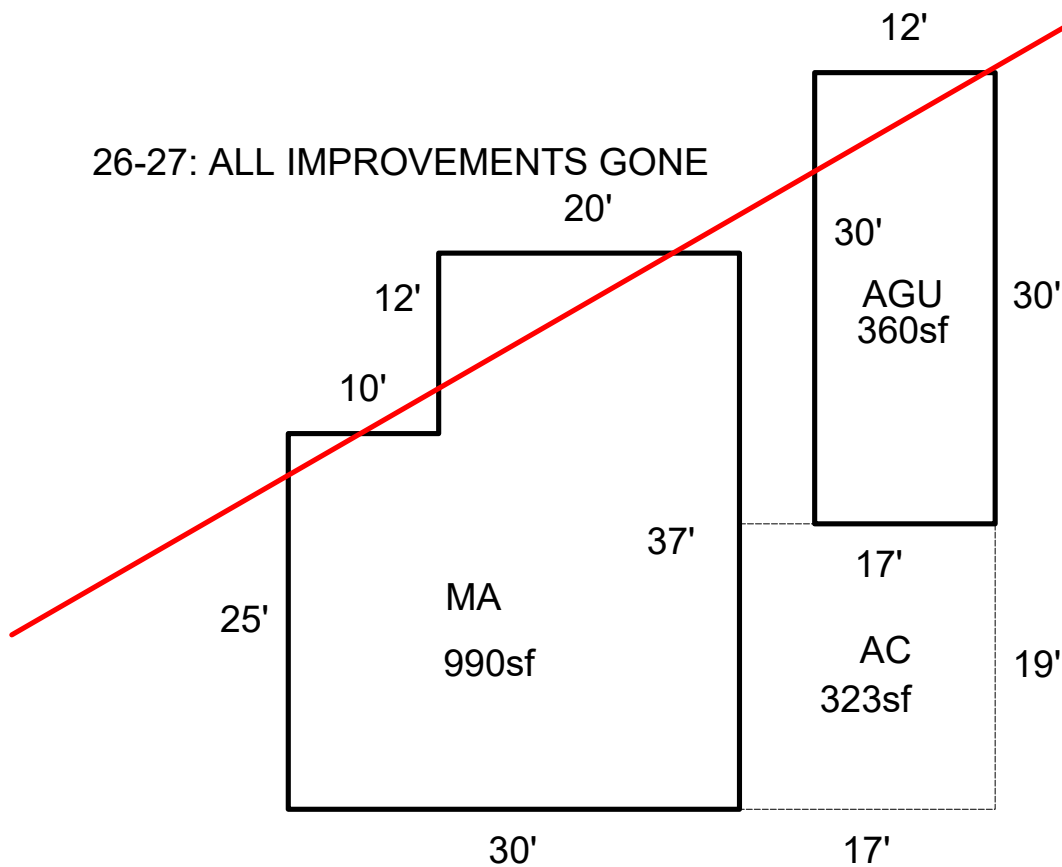

Sketch by ApexSketch

AREA CALCULATIONS SUMMARY

Code	Description	Factor	Net Size	Perimeter	Net Totals
GLA1	MA	1	990	134	990
AC	AC	1	323	72	323
DG	AGU	1	360	84	360

COMMENT TABLE 1

DRAWN BY TJS 8-13-13
 UPDATED BY LK 2.3.26

COMMENT TABLE 2

1.16.26 SV GM

COMMENT TABLE 3

Net LIVABLE cnt 0 (rounded) 990