


SKETCH/AREA TABLE ADDENDUM

SUBJECT INFO

File No.: 600527 Parcel No.: 082W23D 01600
 Property Address: 6596 BLAZE PLACE
 City: SALEM County: MARION State: OR ZipCode:
 Owner:
 Client: Client Address:
 Appraiser Name: Inspection Date:

SKETCH

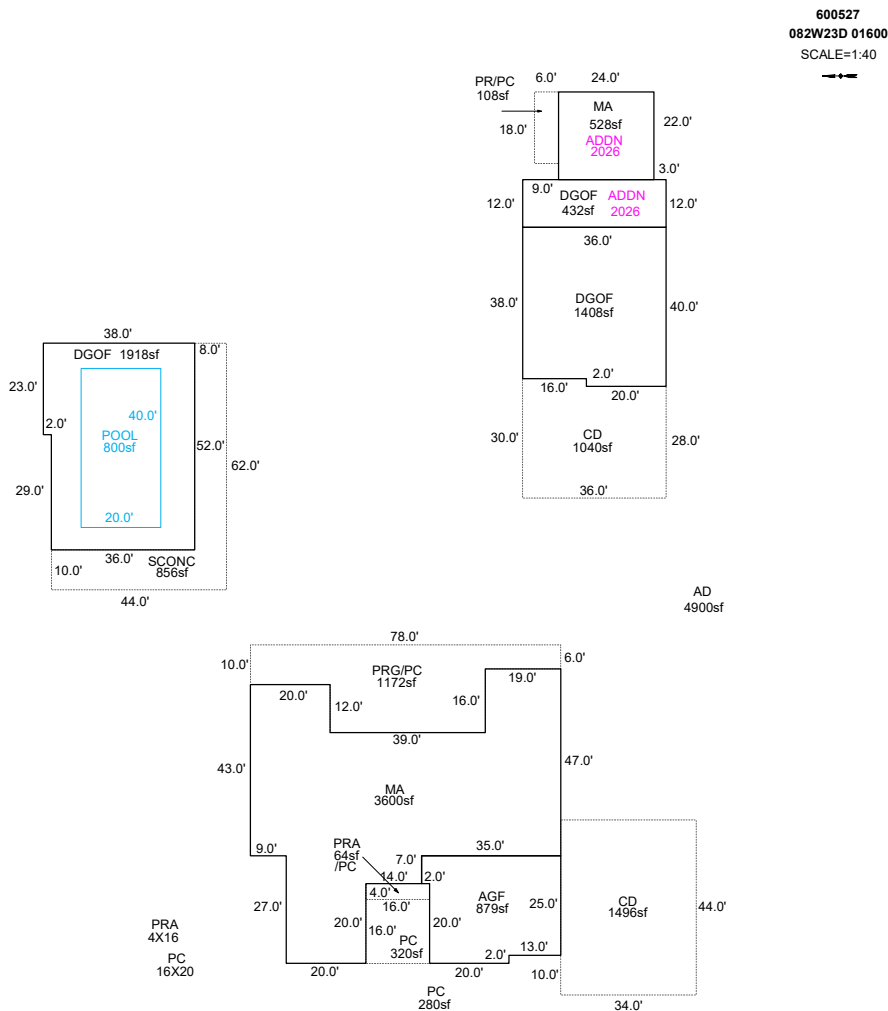

Sketch by ApexSketch

AREA CALCULATIONS SUMMARY

Code	Description	Factor	Net Size	Perimeter	Net Totals
GBA1	DGOF	1.0	1918.0	180.0	
	DGOF	1.0	1408.0	152.0	3326.0
GLA1	MA	1.0	3600.0	328.0	3600.0
GAR	AGF	1.0	879.0	124.0	
	DGOF	1.0	432.0	96.0	1311.0
MA	MA	1.0	528.0	92.0	528.0
OTH	POOL	1.0	800.0	120.0	800.0
P/P	PC	1.0	320.0	72.0	
	PRA	1.0	64.0	40.0	
	PRG/PC	1.0	1172.0	200.0	
	SCONEC	1.0	856.0	212.0	
	CD	1.0	1040.0	132.0	
	CD	1.0	1496.0	156.0	4948.0
PR/PC	PR/PC	1.0	108.0	48.0	108.0
	Net LIVABLE	cnt	3 (rounded)		5,439
	Net BUILDING	cnt	0 (rounded)		3,326

COMMENT TABLE 1

APEX BY CJURAN 10/07/2021 555-21-001072
 & 555-20-007190 & 555-20-008385
 UPDATED BY CLOBERG 02/26/26 25-009351 ADDN

COMMENT TABLE 2

CL #10 10/18/2021

COMMENT TABLE 3

TAGS L2