

# SKETCH/AREA TABLE ADDENDUM

## SUBJECT INFO


File No.: 598151 Parcel No.: 105E02DA01900  
 Property Address: 300 Deer St S  
 City: Detroit County: State: OR ZipCode: 97342  
 Owner:  
 Client: Client Address:  
 Appraiser Name: Inspection Date:

## SKETCH

**598151**

**105E02DA01900**

**26-27: MFH=GONE, GM**

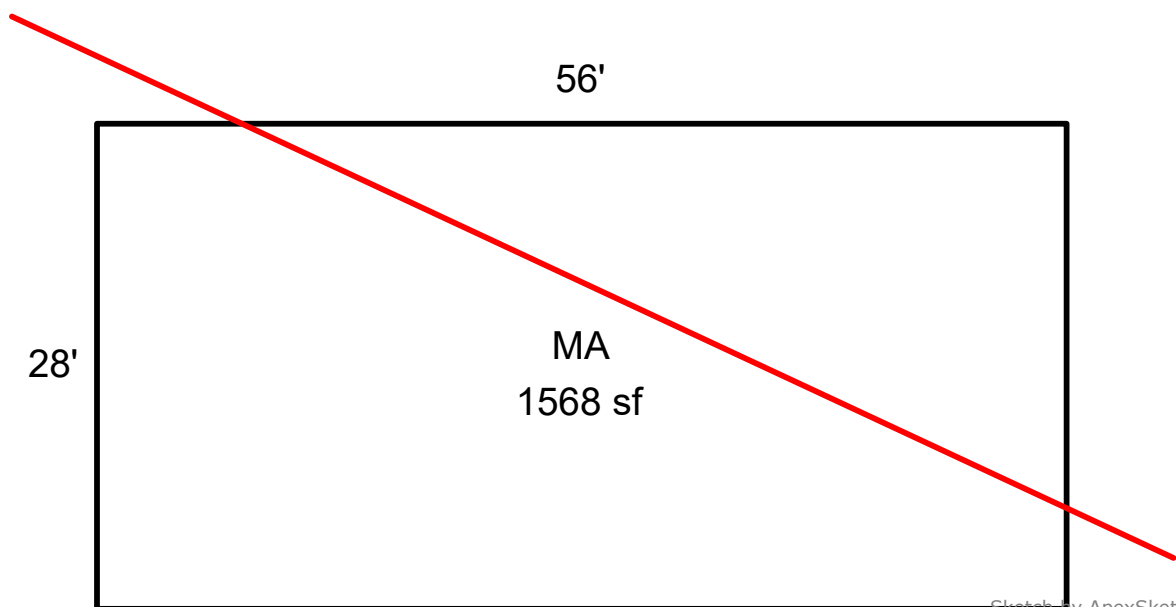

Sketch by ApexSketch

AREA CALCULATIONS SUMMARY						COMMENT TABLE 1	
Code	Description	Factor	Net Size	Perimeter	Net Totals		
GLA1	MA	1.0	1568.0	168.0	1568.0	Apex by RW 06/11/08 UPDATED BY LK 2.17.26	
						COMMENT TABLE 2	COMMENT TABLE 3
						2-1-26 OTHER; GM	
	Net LIVABLE	cnt	0	(rounded)	1,568		