

Acct ID: 536643 MTL: 093W340000100 Date: 4/23/24 Appr: MDL Prop Class: 551 RMV Prop Class: 551
 Situs: _____ MaSaNh: 07 06 000 Unit: 95105 Year: 2024

Last Date Appraised: 11/24/2017 Appraiser: MATT LORD Retag: Y N Tag info: _____
 Owner: PROVIDENCE HOLDINGS-JEFFERSON LLC Roll Type: R
 Cycle Tag Sales Verification Other: _____ Inspection level: 1 2 3 4 LCB TTO INSP AV: 132149
 RMV Land: 428430 RMV Imp: 2800 RMV Total: 431230 MAV: 0 MSAV: 132149 SAV: 396213
 Comment: _____

Notations

No notation data available.

Structure gone Ramp Two MP's N/V

W/O

OSDs

No OSD data available.

Land OK WW

Site: 1 Code Area: 14530 Size: 79.50 Acres Use Code: 005 Zone: REST SAV Use: 011 Exception: 0
 Class: 2BISS Value Source: Farm Use - EFU Description: TWO BENCH IRR SOUTH SPECIAL RMV: 360180 Exception: Y N
 Adjustment(s): GSOIL, IRR Fire Patrol: _____ Description: _____
 Comments: Liability year - 1980 / 81400130: 02-03: CHANGED LAND TABLE FROM 00HGI TO 00GI TO REFLECT PART TOTAL INFORMATION 03-04: REAPPRAISAL

Site: 2 Code Area: 14530 Size: 16.50 Acres Use Code: 005 Zone: REST SAV Use: 011 Exception: 0
 Class: 4BISS Value Source: Farm Use - EFU Description: FOUR BENCH IRR SPECIAL SOUTH RMV: 68250 Exception: Y N
 Adjustment(s): GSOIL, IRR Fire Patrol: _____ Description: _____
 Comments: Liability year - 1980 / 81400130: 02-03; CHANGED LAND TABLE FROM 00HAI TO OOGI TO REFLECT PART TOTAL INFORMATION

Improvements - Residence / Manufactured Structures

No residence or manufactured structure improvement data available.

Improvements - Accessory Buildings

Bldg: 1 Code Area: 14530 Stat Class: 301 Year Blt: _____ Eff Year Blt: _____ Sq.Ft: 522 % Complete: 100
 Desc: Accessory Improvements & Misc. Dimensions: 58x9 RMV: 2800
 Func Obsc: 100 Econ %: 100 Other %: 100 Exception: 0 Adjust: _____ Adjust RMV: 0

Floors


Type	Class	Display Group	Floor Size	Beds	Baths	Yr Blt	Eff Yr Blt	Inventory
Building Structure	0	Finished	522	0	0	0	0	Exception: Y N

Removed

Accessories

Description	Class	Size SqFt	Eff Yr Blt	RMV	Quantity
No accessory data available					

APEX CREATED

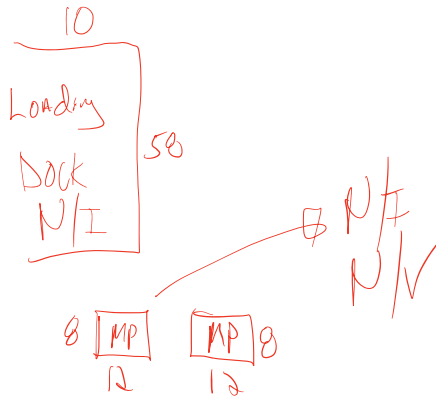

*MDL 4/23/24
L4 cycle*