


SKETCH/AREA TABLE ADDENDUM

SUBJECT INFO

File No.: 611875 Parcel No.: 083W22CA11600
 Property Address: 6630 Maddie Nichole St SE/6630 Maddie Nichole St SE Unit A
 City: Salem County: Marion State: OR ZipCode: 97306
 Owner:
 Client: Client Address:
 Appraiser Name: Inspection Date:

SKETCH

611875
083W22CA11600

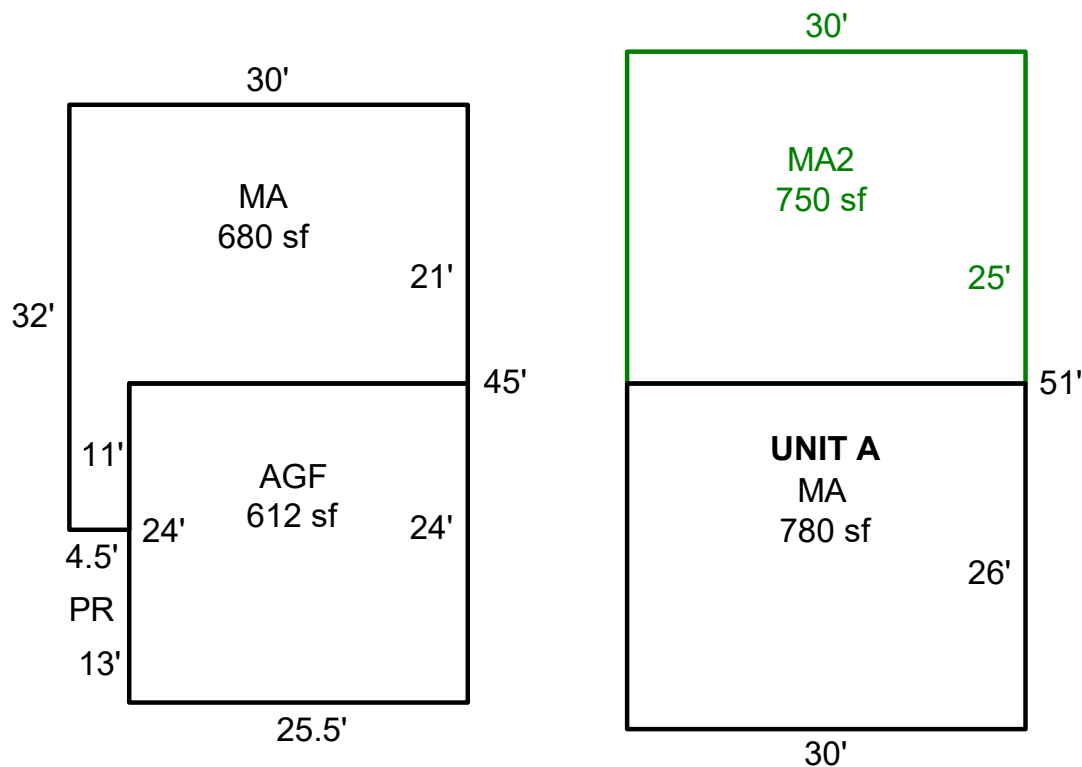

Sketch by ApexSketch

AREA CALCULATIONS SUMMARY						COMMENT TABLE 1	
Code	Description	Factor	Net Size	Perimeter	Net Totals		
GLA	MA	1.0	679.5	124.0		Drawn by AE 5.29.26	
	MA	1.0	780.0	112.0	1459.5		
GLA2	MA2	1.0	750.0	110.0	750.0		
GAR	AGF	1.0	612.0	99.0	612.0		
Net LIVABLE		cnt	3 (rounded)		2,210		
						COMMENT TABLE 2	COMMENT TABLE 3